

# Exemption from Building Consent (exemption 2 only)

## APPLICATION FORM – BUILDING CONSENT EXEMPTION

under Building Act 2004 Schedule 1(2)


**RECEIVED**  
**Gore District Council**  
**20 JAN 2021**  
**1:28 PM**

**OWNER / APPLICANT** (attach evidence of ownership to this application, and if not the owner, attached details of authorisation to lodge application on owner's behalf).

Name: Hashem Ramezanzadeh Phone No: 03 2090330

Postal address: 29 Bowler Ave, Gore Cell phone: 021 1957018

Fax: \_\_\_\_\_

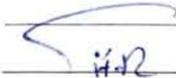Signature:  Email: HRamezan-zadeh@goredc

Date: 20 January 2021

**BUILDING LOCATION**

Street address: 69 Wentworth Street EAST GORE

(or RAPID number) \_\_\_\_\_

Legal description: \_\_\_\_\_

Year of construction: \_\_\_\_\_ Valuation number: \_\_\_\_\_

Current, lawfully established use: Water treatment plant and reservoir

**GORE DISTRICT COUNCIL**  
**APPROVED Schedule 1 Item 2**  
**Exemption # Schedule 1 (2)**  
**Date: 22 November 2023**

**PROJECT** (Provide sufficient description of building works to enable scope of work to be fully understood)

Description of building works Estimated value of work (incl. GST) \$ 650,000

Site leveling and construction of a new building next to the existing water reservoir using precast concrete panels.

Provide details of any proposed new use \_\_\_\_\_

**ATTACHMENTS**

Producer Statements  References to determinations / opinion

Copies of plans and specifications  Photographs

Other: PS2 received 22/11/2023  
Revised drawing set 22/11/2023


**DECISION** (to be completed by the Territorial Authority)

**Approved** – Building consent is not necessary because either:

The completed building work is likely to comply with the building code; or

If the completed building work does not comply with the building code it is unlikely to endanger people or any building, whether on the same land or on other property.

**Not Approved** – A building consent is required for the above project.

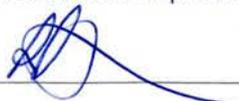Building Control Officer:  Date: 22/11/2023

**PLEASE NOTE:** assessment of the information provided with this application has only been made in consideration of the Building Act 2004. Additional authorisations may be required under other legislation including the Resource Management Act, Health Act, Sale and Supply of Alcohol Act etc. and remain the responsibility of the owner to check.

**FEES:** An assessment fee plus time spent will be invoiced as per the Councils fee schedule.

Assessment fee \$ 150.00 plus 2 hours = \$ 450.00 Invoiced: Y  N

*\* waived fee due to time lapse* 

Additional processing/RFI notes

BC No Sched 1 (2)

BCO

Russell Petersen

\* Gore WWTP upgrade - 69 Wentworth St (East Gore)

Darryl Kensington PSI CPEng 87325 - current structural comp.  
PSI states CMI - overview to provide PS4? ✓

### Specification

#### Section 2 - Concrete

3.10 - Inspections by TA inspector?

3 Waters/Engineer.

#### Section 3 - Precast concrete

1.3 - PS3 from supplier/installer of panels

- Are they viewed by Darryl & pre-pour?

} Yes.

2.1 - 40 MPa for precast panels


2.2 - 300E + 500E deformed bar, Reidbar

Mesh to AS/NZS 4671.

#### Section 4 - Concrete Maturity

1.4 - Inspections at critical stages? Who by? Engineer.

\* PS2 received, suitable to now issue the Schedule 1 (2) exemption, on the basis of being under engineer supervision and likely to comply with the Building Code.

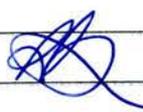 22/11/2023


\* Note: This documentation was supplied to 3 waters on 15 July 2021 however had not been forwarded to Building Control for completion of the Schedule 1 (2) assessment. (The project lead for this development left Council employment and the continuation of documentation supply did not happen as it should have)

Additional processing/RFI notes

BC No \_\_\_\_\_

BCO \_\_\_\_\_

[Empty rectangular box for notes]

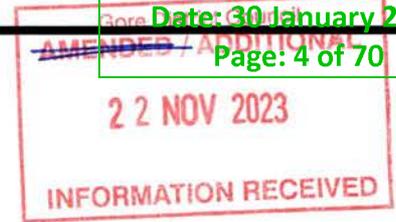

\* Received and added into the Schedule 1 (2) application documents.

**Russell Paterson**

**From:** Matt Bayliss  
**Sent:** Wednesday, 22 November 2023 11:34 a.m.  
**To:** Russell Paterson  
**Subject:** FW: GDC WTP Peer Review Closeout  
**Attachments:** Beca PS2 - Gore WTP Building.pdf

**Follow Up Flag:** Follow up  
**Flag Status:** Flagged

---

**From:** Alex Kelly <Alex.Kelly@beca.com>  
**Sent:** Thursday, July 15, 2021 12:53 PM  
**To:** Darryl Kensington <darryl@kensingtonconsulting.co.nz>; Hashem Ramezan-zadeh <HRamezan-zadeh@goredc.govt.nz>  
**Cc:** 'Donovan Harvey (Donovan@marshalls.co.nz)' <Donovan@marshalls.co.nz>; Greg Philips <Greg.Philips@beca.com>; 3333221 - Centralization of Gore WTP <project-35615@workspace.beca.com>; John Heenan <John.Heenan@beca.com>; James Washbrooke <James.Washbrooke@beca.com>; Matt Bayliss <MBayliss@goredc.govt.nz>  
**Subject:** GDC WTP Peer Review Closeout

Hi Darryl, Hashem,

Please find attached our PS2 for the Gore WTP New Building, along with associated supporting documentation.

Many thanks,

**Alex Kelly**  
Structural Engineer  
Beca  
Phone +64-3-366-3521  
DDI +64-3-367-2465 Mobile +64-27-801-9404  
[alex.kelly@beca.com](mailto:alex.kelly@beca.com)  
[www.beca.com](http://www.beca.com)

Sensitivity: General

---

**From:** Alex Kelly  
**Sent:** Tuesday, 13 July 2021 3:41 PM  
**To:** Darryl Kensington <darryl@kensingtonconsulting.co.nz>  
**Cc:** 'Donovan Harvey (Donovan@marshalls.co.nz)' <Donovan@marshalls.co.nz>; Hashem Ramezan-zadeh <HRamezan-zadeh@goredc.govt.nz>; Greg Philips <Greg.Philips@beca.com>; 3333221 - Centralization of Gore WTP <project-35615@workspace.beca.com>  
**Subject:** RE: peer review document response

Hi Darryl,

I have discussed the brace connection further with Abbas on a separate email chain from him to close this out. He should hopefully be getting back to you with the revised details required for the bracing drawings. Once that is complete, can you please send a full set of the revised drawings, full Design Features Report and the PS1, along with a document transmittal from yourself covering all these items and their current revisions and dates (required for attachment to the PS2).

Further to query #29 on the Peer Review register, can you confirm in writing that Steve Knowles is covered by Kensington Consulting's PI insurance as signatory to the PS1.

Cheers,  
Alex

**GORE DISTRICT COUNCIL**  
**APPROVED Schedule 1 Item 2**  
**Exemption # Schedule 1 (2)**  
**Date: 30 January 2024**  
**Page: 5 of 70**

Sensitivity: General

**From:** Darryl Kensington <[darryl@kensingtonconsulting.co.nz](mailto:darryl@kensingtonconsulting.co.nz)>  
**Sent:** Tuesday, 13 July 2021 9:11 AM  
**To:** Alex Kelly <[Alex.Kelly@beca.com](mailto:Alex.Kelly@beca.com)>  
**Cc:** Abbas Mirfattah <[abbas.mirfattah@enlink.co.nz](mailto:abbas.mirfattah@enlink.co.nz)>; [steven.knowles@sjgd.co.nz](mailto:steven.knowles@sjgd.co.nz); 'Donovan Harvey (Donovan@marshalls.co.nz)' <[Donovan@marshalls.co.nz](mailto:Donovan@marshalls.co.nz)>  
**Subject:** peer review document response

Morning Alex please find attached response and supporting documents after your discussion with Abbas yesterday. As the detailed cleats are all fabricated to the main portals we have provided an extended fully welded cover plate over the original (butt welds will be QA tested) and will redrill for new M20 bolts as detailed. Could you please advise me this morning that this detail is accepted so that fabricator can be advised. Many thanks  
Cheers Darryl

Darryl Kensington BE Civil, CMEngNZ (Civil,Structural), CPEng, IntPE(NZ)

**Kensington Consulting**  
//// Civil and Structural Engineers

Findex House  
173 Spey Street  
Invercargill  
P: 03 218 7936  
M: 027 403 3773

NOTICE: This email, if it relates to a specific contract, is sent on behalf of the Beca company which entered into the contract. Please contact the sender if you are unsure of the contracting Beca company or visit our web page <http://www.beca.com> for further information on the Beca Group. If this email relates to a specific contract, by responding you agree that, regardless of its terms, this email and the response by you will be a valid communication for the purposes of that contract, and may bind the parties accordingly. This e-mail together with any attachments is confidential, may be subject to legal privilege and applicable privacy laws, and may contain proprietary information including information protected by copyright. If you are not the intended recipient, please do not copy, use or disclose this e-mail; please notify us immediately by return e-mail and then delete this e-mail.



association of consulting and engineering



Building Code Clause(s) B1

PRODUCER STATEMENT – PS2 – DESIGN REVIEW

GORE DISTRICT COUNCIL APPROVED Schedule 1 Item 2 Exemption # Schedule-1 (2) Date: 30 January 2024 Page: 6 of 70

ISSUED BY: Beca Limited (Design Review Firm)
TO: Gore District Council (Owner/Developer)
TO BE SUPPLIED TO: Gore District Council (Building Consent Authority)
IN RESPECT OF: Gore Water Treatment Plant Upgrade - New Building (Description of Building Work)
AT: Wentworth Street, East Gore (Address)

Town/City: Gore (Address) LOT DP SO

We Beca Limited (Design Review Firm) have been engaged by Gore District Council

to review the design documents for this project in respect of the requirements of Clause(s) B1 Structure of the Building Code.

The Review is for All or Part only of the design work prepared by Kensington Consulting Ltd (Design Firm)

as described in drawings titled Gore Water Treatment Plant Upgrade - New Building

and numbered S01 - S13 together with the specification, and other documents set out in the schedule attached to this statement according to which the building is proposed to be constructed.

The Review is in respect of Structural Engineering (aspects of design) or per attached schedule.

The Review confirms that these aspects of the design are in accordance with:

Compliance Documents issued by the Ministry of Business, Innovation & Employment B1/VM1, B1/VM4 (verification method/acceptable solution)

Alternative solution as per the attached schedule

On behalf of the firm undertaking this review, on the basis of the review undertaken, and subject to:

- (i) Site verification of the following design assumptions Confirmation of soil bearing capacity at founding depth
(ii) All proprietary products meeting their performance specification requirements;

I believe on reasonable grounds that a) the building, if constructed in accordance with the drawings, specifications, and other documents provided or listed in the attached schedule, will comply with the relevant provisions of the Building Code and that b), the persons who have undertaken the review have the necessary competency to do so.

I, John Heenan am: CPEng # 111129 (Name of Design Review Professional)

I am a member of: Engineering New Zealand and hold the following qualifications: NZCE BE CMEngNZ CPEng IntPE(NZ)

The Design Review Firm issuing this statement holds a current policy of Professional Indemnity Insurance no less than \$200,000\*.

The Design Review Firm is a member of ACE New Zealand:

SIGNED BY John Heenan (Signature)

ON BEHALF OF Beca Limited (Design Review Firm) Date 15-07-2021

Note: This statement shall only be relied upon by the Building Consent Authority named above. Liability under this statement accrues to the Design Review Firm only. The total maximum amount of damages payable arising from this statement and all other statements provided to the Building Consent Authority in relation to this building work, whether in contract, tort or otherwise (including negligence), is limited to the sum of \$200,000\*.

This form is to accompany Form 2 of the Building (Forms) Regulations 2004 for the application of a Building Consent.

THIS FORM AND ITS CONDITIONS ARE COPYRIGHT TO ACE NEW ZEALAND AND ENGINEERING NEW ZEALAND



## **Producer Statement – Peer Review (PS2) Schedule**

We have reviewed the following documents as part of the peer review of the Gore Water Treatment Plant Upgrade – New Building project:

- Drawings by Kensington Consulting Ltd as per the attached schedule from SJ Gordon Design Ltd.
- Structural Design Calculations:
  - Initial set received 25 March 2021
  - Revised calculations received 13 May 2021
  - Revised calculations received 15 June 2021
  - Revised calculations received 13 July 2021
- Structural Specification Rev1 by Kensington Consulting Ltd.
- Design Features Report dated 14 July 2021 from SJ Gordon Design Ltd.
- Producer Statement PS1 from SJ Gordon Design Ltd.
  - Confirmation via letter from Kensington Consulting that SJ Gordon Design Ltd is engaged by Kensington Consulting Ltd as a subconsultant to the lead engineer for Marshall Projects to Gore District Council. As such the provisions of Professional Indemnity Insurance as stated on the PS1 are applicable to Kensington Consulting Ltd as Engineer of Record.

**GORE DISTRICT COUNCIL  
APPROVED Schedule 1 Item 2  
Exemption # Schedule 1 (2)  
Date: 30 January 2024  
Page: 7 of 70**

**KENSINGTON CONSULTING**

**//// Civil and Structural Engineers**

20080

14/07/21

Gore District Council  
PO Box 8  
Gore

C/- BECA  
Email; [Alex.Kelly@Beca.com](mailto:Alex.Kelly@Beca.com)

Attention: Alex Kelly


Dear Alex

**Gore Waste-Water Plant Peer Review**

As requested, we advise in response to query #29 of the Peer Review register that SJGD Structures as signatory to the PS1, is covered under Kensington Consulting's PI insurance for this project.

We trust this confirmation is acceptable.

Yours Sincerely

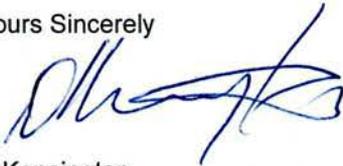

D Kensington  
Director

GORE DISTRICT COUNCIL  
APPROVED Schedule 1 Item 2  
Exemption # Schedule 1 (2)  
Date: 30 January 2024  
22 NOV 2023  
Page: 8 of 70  
INFORMATION RECEIVED

Sensitivity: General

Peer review comment register		Reviewer comment		Designer response		Reviewer comments 2		Status	Designer response 2	
NL	Doc reference	Importance	Date	Comment	Date	Comment	Date	Comment	Date	Comment
			25/01/21	Please provide a copy of the calculations			23/04/21	Received		
			25/01/21	Please provide a copy of the DFR			23/04/21	Received		
2	Drawing S01		25/01/21	Mesh laps seems too small. 23/4 - Not changed.		Mesh lapping to be in accordance with the manufacturers standard requirements	28/05/21	Add note, "min two transverse wires lapped".	15/06/21	Note added to drawing S01
3	Drawing S01		25/01/21	Why have not all north precast panels got a grout infill between them? 23/4 - Not clear which joints are grouted now that the detail has changed.		Joints only grouted to panels affected by chlorine room fire requirements and those forming bundled area to provide a fully sealed joint with solid backing. Panels P12-P19 externally and panels P26-P28 internally	28/05/21	Drawings show P11-P12 also grouted. Note on S09 referencing the required panels to be grouted has been deleted.	15/06/21	List of panel grouted joints added to drawing S09
4	Drawing S01		25/01/21	Drainage outlets how are these detailed through the ground floor slab/beam? 23/4 - Detail updated, need to review		The drains have been regraded on revised drawings to enable the drains to exit out through base of the panel as detailed on sheet S04 section E1	28/05/21	P18 not updated with penetrations. Where does the chlorine room drain drain too? Are grates being provided over the strip drains.	15/06/21	The drain from the chlorine room exits via cored hole and pipe sleeve to external drainage sump beside the foundations. The external drainage works was not part of Kensington Consulting scope of work. Stainless steel grated drainage covers have been noted on the drawings as discussed with GDC. The drains exit out through base of the panel as detailed on drawing
5	Drawing S01		25/01/21	Is the dosage rate for the fibres, of 1 kg, for the whole floor slab or should this be a rate, ie xkg/m3? 23/4 - no update.		Yes confirming that the dosage rate is 1kg/ m3. Contractor is aware of this	28/05/21	Noted. We have not reviewed the dosage rate.		
6	Drawing S01		25/01/21	The calls up for anchor studs as grade 8.8, should these be 4.6 for a bit more flexibility, although they have a lower capacity? 23/4 - no update.		This was originally a general note but is not really required now as all the various fixing requirements are specified where required. Drawing S01 Rev B revised to reflect this	28/05/21	Noted		
7	Drawing S01		25/01/21	Where studs are stainless steel, how is the bimetallic corrosion being dealt with? 23/4 - no update.		HDPE washers and epoxy paint coating. Revised section D / D1 sheet S04 Rev B	28/05/21	Noted		
8	Drawing S01		25/01/21	Are there any higher requirement of corrosion resistance to the steelwork in the chlorine dose room? 23/4 - No update.		This question was directed to our client who responded that no additional coating requirement was required. Copy of email response attached refer query 8 document	28/05/21	We would recommend that this is reviewed by a corrosion specialist.	15/03/21	Coating spec changed in steel spec however contractor has offered an PURB compliant alternative which is acceptable and we will accept
9	Drawing S13		25/01/21	Loads for the design of the precast floor units that form the roof to the chlorine room have not been provided. Please provide.		This was intended as a ceiling only but have allowed for a nominal 3Kpa UDL in case of some minor storage as access is very restricted but have allowed for a point load of 1kN for a There is a 100mm step in the slab at the offices end of the building and sheets S 01 and S04B. Indicate these details	23/04/2021 28/05/2021	Drawings updated for live load. Point load not specified. Need to specify point load to NZS 1170.	15/06/21	The as agreed 3.5KN point load in addition to the 3KPa UDL has been added to the drawing S13 and the precast spec updated.
10	Drawing S01		25/01/21	Is there a fold in the ground floor slab, we believe there should be, if so what is the detail. 23/4 - no update.		Yes, See page RFI-1	28/05/21	Unclear if panel are tied together and detailed as such.		
11	Drawing S02		25/01/21	Has the eastern wall been designed to take approximately 10m trib of seismic load for the building? 23/4 - calcs to be reviewed.		Current detail of the pillar is fine. Just drawings to be updated. Trimming bars are added. See page RFI-2. Revised details for P22 drawing S08 Rev B	28/05/21	Noted	15/06/21	Refer to revised calculations and panel drawings
12	Drawing S03		25/01/21	Section C needs updating to show the pillar in panel P22. 23/4 - drawings still inconsistent. Strip of panel adjacent to penetration needs to be detailed appropriately		See page RFI-3	28/05/21	Use of Mu = 1.25 and sp =0.7, is not ok for this connection. Further not considered the combined tensions and shear load. Tension and eccentricity not accounted for together.	15/06/21	Refer to additional calculations
13	Drawings S04 and all Precast wall elevations		25/01/21	Are the HD12-300 shear bars at the base of the precast walls enough for vertical and horizontal loads? How is the eccentricity resolved?		The uplift is not too high due to self weight of the walls and light roof. The anchorage capacity of base is checked see RFI-3	28/05/21	300 kN/m of uplift is high. There is not enough self weight for this.	15/06/21	Refer to additional calculations
14	Drawings S04 and all Precast wall elevations		25/01/21	Under seismic actions how is the panel held down. The uplift seems very high. 23/4 - calcs to be reviewed.		Attached marked up plan which has incorporated the contractors construction joints	28/05/21	Noted		
15	Drawing S04		25/01/21	Saw cuts in the slab, detail is shown but plans do not show layout and location, how does these interact with the plinths? 23/4 - no update.		They can be resisted by the sections capacity See page RFI-5	28/05/2021 09/07/2021	Weak axis being of rafter not checked with major axis bending. Unclear as to how SHS has been checked. Brace connection capacity insufficient (S05, section B and plan). Recommend centrelines of SHS strut, UB portal and Reid braces align, with bolt sizes increased to M20's (same as RB20 pins) and in line with RB centrelines to take force without any eccentricity. Connection has not been reviewed for eccentricity.	15/06/21	refer additional calculations
17	Drawing S05		25/01/21	The bracing connection plate are connected to the web, has this been checked? 23/4 - calcs to be reviewed.		There are stiffeners and also struts very close to the connection and eccentricity is resisted by strut section See page RFI-5	28/05/21		15/06/21	The roof level bracing/ struts shifted up to align with the UB top flange to reduce eccentricity. Drawings revised to reflect this
18	Drawing S05		25/01/21	100SHS welds, bolts cleat size to be defined		Refer revised drawing 07A	23/04/21	Size noted		
19	Drawing S07A		25/01/21	Section AA, this element adjacent to the door should be detailed as a column. 23/4 - no update.		Refer revised drawing 07A	28/05/21	Noted		
20	Drawing S07A		25/01/21	Trimming around openings in the precast, trimmer bars either side should be added. 23/4 - no update.		Refer revised drawing 08	28/05/21	Noted		
21	Drawing S08		25/01/21	Section AA, this element adjacent to the door should be detailed as a column. Also the struts should extend above and below the opening at least 300mm 23/4 - no update.			28/05/21	Noted		

**INFORMATION RECEIVED**  
**22 NOV 2023**  
 Gore District Council  
 AMENDED - ADDITIONAL

N.	Doc reference	Importance	Reviewer comment		Designer response		Reviewer comments 2		Status	Designer response 2	
			Date	Comment	Date	Comment	Date	Comment		Date	Comment
22	Drawings S09		25/01/21	I don't think there is a panel 29? 23/4 - detail has been removed without being clouded. Not sure if this is correct? Please review and confirm?		There is no panel 29 this was a typing error on the original drawings	28/05/21	Noted	Closed		
23	Drawing S10		25/01/21	Panel P10 (and other similar panels) the 2-HD16 bars should be confined similar to the grout ducts? 23/4 - no update		Refer to revised drawings S10,S11	28/05/21	Noted	Closed		
24	Drawing S10		25/01/21	Panel P10 (and other similar panels) are the 2-HD16 bars developed?			23/04/21	hooks added	Closed		
25			29/01/21	Please provide the geotechnical report 23/4 - DFR states 300kPa ultimate bearing, however not noted on drawings and geotech report has not been provided for our review.		There was no Geotech report as such. We went to site and attempted to undertake a series of scale penetrometer tests but the entire area is a siltstone rock. The site is adjacent to the existing reservoir and the area was excavated at the same time for an adjacent reservoir space. The foundation trenches were excavated down into this rock which is ripplable with a large excavator which is what they used. The 300kPa geotechnical ultimate bearing used in this project was derived from a geotech report for another project some 700-800m away from the site in an outcrop of the same rock material. Copy of the report and photo of exposed rock in the excavation for that	28/05/21	This is not good practice. This structure is more critical and important than a house and a site specific geotech report is probably justified.	Closed	15/06/21	Agreed that Kensington Consulting will undertake scale tests and record for perimeter foundations
26			29/01/21	Is there any back fill required under the slab? 23/4 - no update		Minor 100mm depth of compacted hardfill beneath the raised slab under office area.	28/05/21	This would be good practice, but would depend on your ground conditions.	Closed	15/06/21	minimal Compacted depth of hardfill over the basement rock effectively as a blinding layer to the rock surface to lay DPC and construct slab
27	Drawings S05		29/01/21	What bolt tightening is required for the splice connection, snug, TF? 23/4 - no update		Snug tight. Added to drawing section for clarity however Steelwork general notes on sheet S02 also covered this.	28/05/21	The SCNZ standard connections call up TB bolts for this type of splice.	Closed	15/06/21	Bolts changed to T/B on drawing S05
28	Drawing S02		29/01/21	Have the secondary effects of the precast loading the 250PFC edge beam been reviewed? 23/4 - calcs to be reviewed.		The 250 PFC along the eave is mainly under one action that is out of plane of the walls (mainly self weight as vertical load). The lateral deformation of these beams are checked See RFI-4	28/05/21	Eccentricities from the bolt to beam centroid needs to be considered.	Closed	15/06/21	refer to previous comments RF4 and the revised calculations
29	PS1		28/05/21	Why is a different company signing the PS1 than the design engineer?			9/07/2021	Kensington Consulting via Marshall Projects to confirm engineer of record (ie liable to Gore DC via Marshalls for defects, warranty period, PI insurance etc).	Closed	15/06/21	ps1 revised to reflect work being undertaken on behalf of Kensington Consulting
							15/07/2021	Letter stating Steve Knowles of SIGD Structures as signatory to the PS1 is covered by Kensington Consulting's PI Insurance.			
30											
31											
**INFORMATION RECEIVED**  
22 NOV 2023  
 Gore District Council  
 AMENDMENT / ADDITIONAL



**GORE DISTRICT COUNCIL**  
 APPROVED Schedule 1 Item 2  
 Exemption # Schedule 1 (2)  
 Date: 30 January 2024  
 Page: 11 of 70  
INFORMATION RECEIVED

Building Code Clause(s) B1 - Structure

**PRODUCER STATEMENT – PS1 – DESIGN**

(Guidance on use of Producer Statements (formerly page 2) is available at [www.engineeringnz.org](http://www.engineeringnz.org))

ISSUED BY: SJ Gordon Design Ltd on behalf of Kensington Consulting  
(Design Firm)

TO: Marshall Projects  
(Owner/Developer)

TO BE SUPPLIED TO: Gore District Council  
(Building Consent Authority)

IN RESPECT OF: Gore Water Treatment Plant  
(Description of Building Work)

AT: Wentworth St, East Gore  
(Address)

Town/City: Gore LOT ..... DP ..... SO .....

We have been engaged by the owner/developer referred to above to provide:

Design services for the primary building structure as identified in the attached Design Features Report  
(Extent of Engagement)

services in respect of the requirements of Clause(s) B1 of the Building Code for:

All or  Part only (as specified in the attachment to this statement), of the proposed building work.

The design carried out by us has been prepared in accordance with:

Compliance Documents issued by the Ministry of Business, Innovation & Employment B1/MM1 or  
(verification method/acceptable solution)

Alternative solution as per the attached schedule.....

The proposed building work covered by this producer statement is described on the drawings titled:

Gore Water Treatment Plant Upgrade - New Building and numbered 20080 Sheets S01 to S13  
 together with the specification, and other documents set out in the schedule attached to this statement.

On behalf of the Design Firm, and subject to:

- (i) Site verification of the following design assumptions NZS3604 Good ground
- (ii) All proprietary products meeting their performance specification requirements;

I believe on reasonable grounds that a) the building, if constructed in accordance with the drawings, specifications, and other documents provided or listed in the attached schedule, will comply with the relevant provisions of the Building Code and that b), the persons who have undertaken the design have the necessary competency to do so. I also recommend the following level of construction monitoring/observation:

CM1  CM2  CM3  CM4  CM5 (Engineering Categories) or  as per agreement with owner/developer (Architectural)

I, Steven David Knowles am:  CPEng 151244 #  Reg Arch ..... #  
(Name of Design Professional)

I am a member of:  Engineering New Zealand  NZIA and hold the following qualifications: BE, CPEng, CMEngNZ

The Design Firm issuing this statement holds a current policy of Professional Indemnity Insurance no less than \$200,000\*.

The Design Firm is a member of ACENZ:

SIGNED BY Steven David Knowles (Signature) Steven Knowles Digitally signed by Steven Knowles Date: 2021.03.18 21:20:40 +1300  
(Name of Design Professional)

ON BEHALF OF SJ Gordon Design Ltd on behalf of Kensington Consulting Date 14 July 2021  
(Design Firm)

*Note: This statement shall only be relied upon by the Building Consent Authority named above. Liability under this statement accrues to the Design Firm only. The total maximum amount of damages payable arising from this statement and all other statements provided to the Building Consent Authority in relation to this building work, whether in contract, tort or otherwise (including negligence), is limited to the sum of \$200,000\*.*

This form is to accompany **Form 2 of the Building (Forms) Regulations 2004** for the application of a Building Consent.  
 THIS FORM AND ITS CONDITIONS ARE COPYRIGHT TO ACENZ, ENGINEERING NEW ZEALAND AND NZIA

GORE DISTRICT COUNCIL  
APPROVED Schedule 1 Item 2  
Exemption # Schedule 1 (2)  
Date: 30 January 2024  
Page: 12 of 70



S J Gordon Design Ltd

To Gore District Council  
CC  
From Steven Knowles  
Ref No 4248

Page 1 of 1

Date 14 July 2021

## Attachment to PS1 – 14 July 2021


### - Drawings

Gore Water Treatment Plant Upgrade – New Building

Project Number	Drawing Number	Revision
20080	S01	B
20080	S02	B
20080	S03	B
20080	S04	C
20080	S04B	C
20080	S05	E
20080	S06	A
20080	S07A	B
20080	S07B	B
20080	S08	B
20080	S09	A
20080	S10	B
20080	S11	B
20080	S12	A
20080	S13	C

Gore District Council  
 AMENDED  
 22 NOV 2023  
 INFORMATION RECEIVED

ORIGINAL SIZE (A1) DO NOT SCALE PLOT DATE 13-May-21  
 ORIGINAL SIZE (A1) DO NOT SCALE

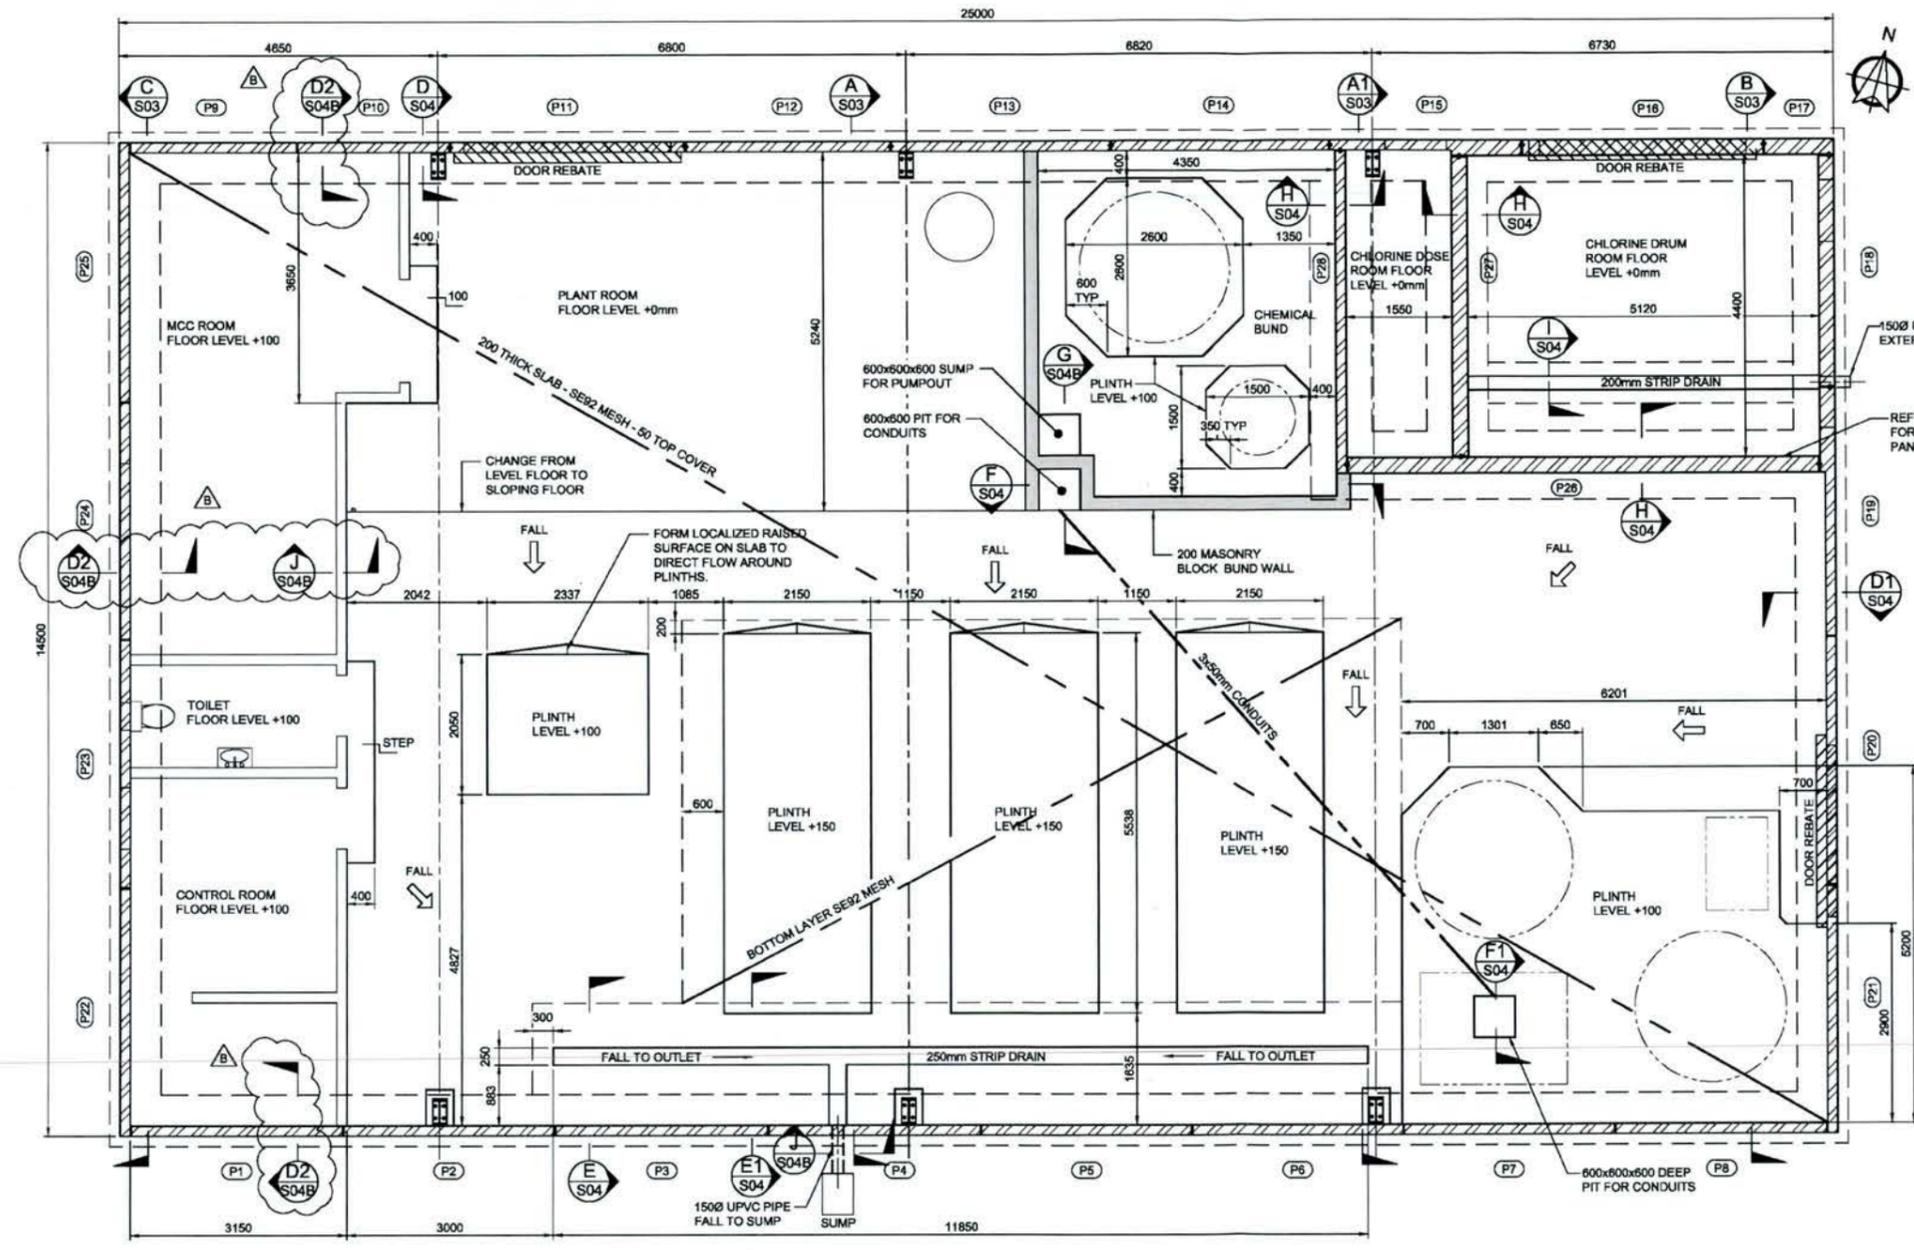

**FLOOR PLAN**  
 1:50 at A1  
 1:100 at A3

- GENERAL NOTES**
- FOUNDATION BEARING BASED ON 300kPa GEOTECHNICAL ULTIMATE CAPACITY.
- CONCRETE NOTES**
- CONCRETE STRENGTH SHALL BE 25 MPa AT 28 DAYS FOR FOUNDATIONS / FLOOR CONCRETE AND MASONRY BLOCK GROUT. THE FLOORSLAB SHALL ALSO CONTAIN MIN 1kg/m<sup>3</sup> POLYPROPYLENE FIBRE.
  - CONCRETE STRENGTH SHALL BE 40 MPa AT 28 DAYS FOR PRECAST PANELS.
  - ALL STRUCTURAL CONCRETE SHALL BE CERTIFIED "SPECIAL GRADE" WITH AQUORON 300 ADDED AS PER MANUFACTURES SPECIFICATIONS.
  - REINFORCING LAP LENGTHS: HD10 - 700 mm, HD12 - 850 mm, HD16 - 1,050 mm, MESH - 260 mm
  - ALL REINFORCING STEEL SHALL HAVE 75mm MINIMUM COVER IN FOUNDATIONS, UNLESS NOTED OTHERWISE.
  - PRECAST MINIMUM COVER - 35mm 55mm COVER TO INTERIOR FACES OF CHLORINE DRUM ROOM WALLS / ROOF.
  - BAR DESIGNATION: HD = GRADE 500E DEFORMED BARS; D = GRADE 300E DEFORMED BARS; R = GRADE 300E ROUND BARS; RB = GRADE 500 (REID BAR) DEFORMED BARS.
  - BASE PLATE GROUTING - USE SIKA GROUT 212 OR APPROVED EQUIVALENT.
  - STARTER BAR GROUTING - USE RAMSET EPCON C6 OR APPROVED EQUIVALENT.

Rev No	REVISION DESCRIPTION	DRAWN	APPROVED	DATE
B	NOTES MODIFIED	ITB	DK	12-5-21
A	ISSUED FOR CONSTRUCTION	ITB	DK	18-3-21
3	PLINTHS MODIFIED	ITB	DK	9-3-21
2	UPVC PIPE AND SUMPS ADDED	ITB	DK	16-12-20
1	PLINTH RELOCATED	ITB	DK	4-12-20
0	ISSUED FOR CONSENT / CONSTRUCTION	ITB	DK	1-12-20

	BY	DATE
DESIGNED	DK	10-20
DESIGN CHECK	DK	11-20
DRAWN	ITB	10-20
APPROVED		


**KENSINGTON CONSULTING**  
 Civil and Structural Engineers  
 03 218 7936 027 403 3773

**GORE WATER TREATMENT PLANT  
 UPGRADE - NEW BUILDING  
 FLOOR PLAN AND PANEL LAYOUT**

STATUS <b>CONSTRUCTION</b>		
SCALE AT A1		
PROJECT NUMBER <b>20080</b>	DRAWING NUMBER <b>S01</b>	REV. <b>B</b>

Gore District Council  
 AMENDMENT / ADDITION  
 22 NOV 2023  
 INFORMATION RECEIVED

ORIGINAL SIZE (A1) DO NOT SCALE PLOT DATE 11-Jun-21  
 ORIGINAL SIZE (A1) DO NOT SCALE

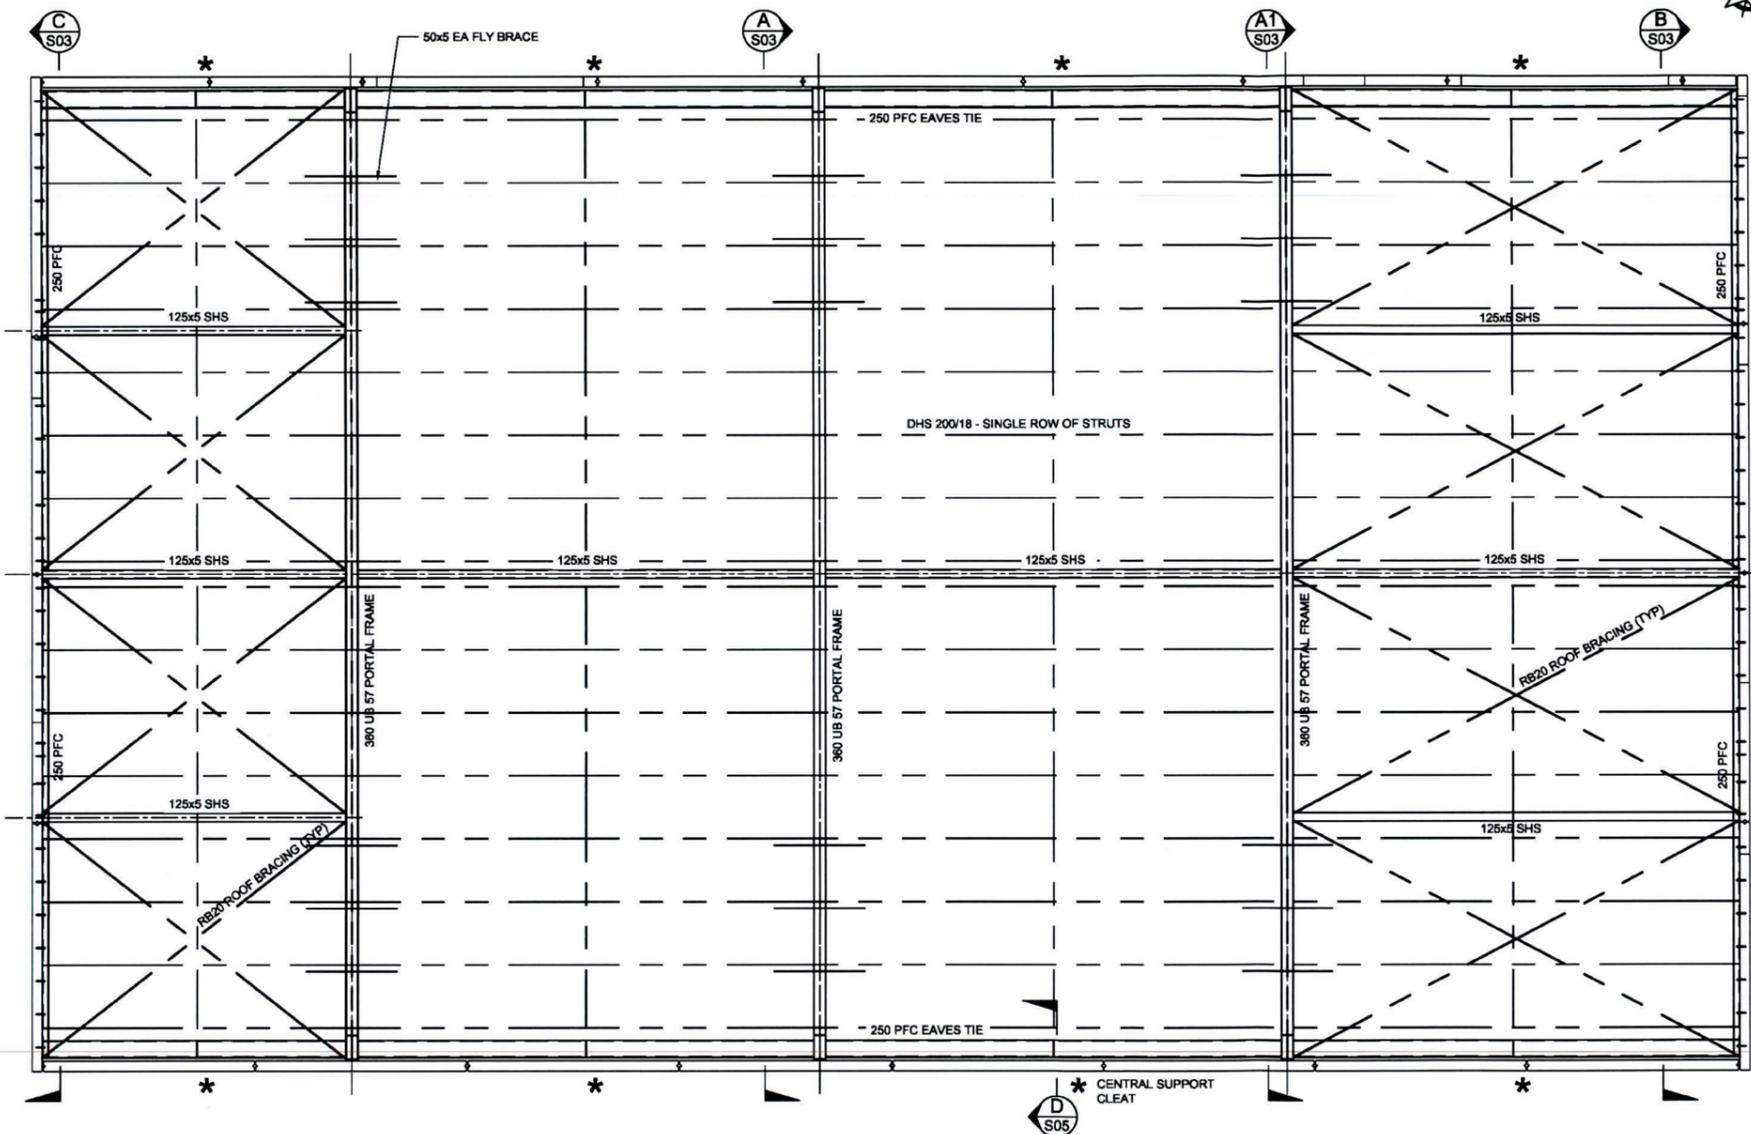

**STEELWORK PLAN**  
 1:50 at A1  
 1:100 at A3

**ROOF**  
 ROOF STRUCTURE SHALL BE AS FOLLOWS -  
 ROOFING KARAKA MARSHALL 6 LINE PROFILE.  
 THERMAKRAFT AUSMESH SAFETY NETTING.  
 COVERTEK 407 ROOF UNDERLAY.  
 PINK BATTS R1.8 ROOF BLANKET.  
 TIMBER PURLINS SCREWED.  
 COVERTEK 401 ROOF UNDERLAY UNDER ROOFING. REFER  
 TO S03 FOR DETAIL.

- STEELWORK NOTES**
1. THE CONTRACTOR SHALL CONFIRM ALL DIMENSIONS AND LEVELS ON SITE PRIOR TO COMMENCING CONSTRUCTION.
  2. ALL PROPRIETARY FITTINGS SHALL BE INSTALLED STRICTLY TO MANUFACTURERS SPECIFICATIONS.
  3. ALL STEELWORK SHALL BE CLEANED TO SA2.5 AND PAINTED IN A SHOP ENVIRONMENT. REFER TO PAINT SPECIFICATION FOR SPECIFIC DETAILS TO ACHIEVE MIN. C4 ATMOSPHERIC CORROSIVE CATEGORY.
  4. ALL SURFACES TO BE WELDED SHALL BE CLEANED OF ALL FOREIGN MATTER TO 60mm EACH SIDE OF THE WELD.
  5. ALL WELDS CONTINUOUS CATEGORY SP E41XX/40X UNLESS NOTED OTHERWISE.
  6. ALL WELDING SHALL BE 6mm FILLET WELDS ALL ROUND UNLESS NOTED OTHERWISE.
  7. ALL STRUCTURAL STEEL OPEN SECTION SHALL BE GRADE 300. ALL CLOSED SECTION SHS AND RHS SHALL BE GRADE 350. ALL BOLTS SHALL BE GALVANISED GRADE 8.8 WITH THREAD NOT PERMITTED WITHIN THE SHEAR PLANE AND TIGHTENED TO A SNUG TIGHT CONDITION (NS). U.N.O.

Rev No	REVISION DESCRIPTION	DRAWN	APPROVED	DATE
B	NOTE MODIFIED	ITB	DK	11:8:21
A	ISSUED FOR CONSTRUCTION	ITB	DK	18:3:21
1	STRUCTS WAS 100x6 SHS NOW 125x5 SHS	ITB	DK	9:3:21
0	ISSUED FOR CONSENT / CONSTRUCTION	ITB	DK	1:12:20


	BY	DATE
DESIGNED	DK	10:20
DESIGN CHECK	DK	11:20
DRAWN	ITB	10:20
APPROVED		

**KENSINGTON CONSULTING**  
 Civil and Structural Engineers  
 03 218 7936 027 403 3773


**GORE WATER TREATMENT PLANT  
 UPGRADE - NEW BUILDING  
 STRUCTURAL STEEL PLAN**

STATUS <b>CONSTRUCTION</b>		
SCALE AT A1		
PROJECT NUMBER <b>20080</b>	DRAWING NUMBER <b>S02</b>	REV. <b>B</b>


Gore District Council  
 AMENDED / ORIGINAL  
 22 NOV 2023  
 INFORMATION RECEIVED

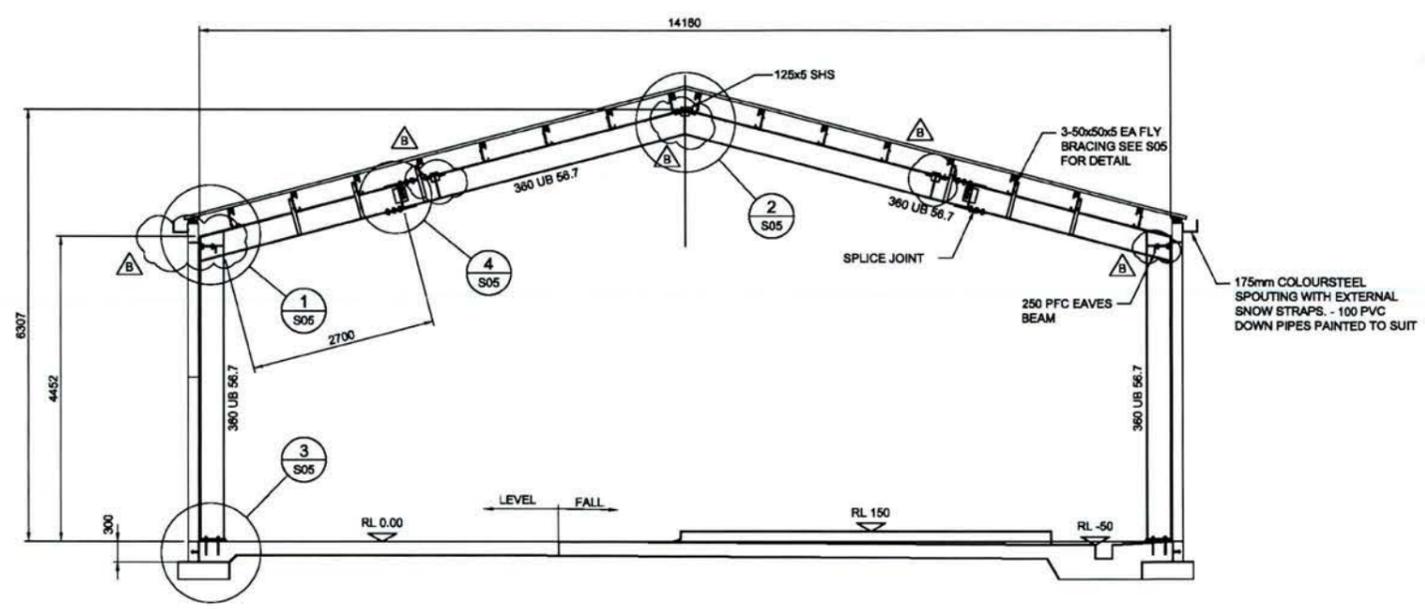


SECTION A & A1  
 1:50 at A1  
 1:100 at A3

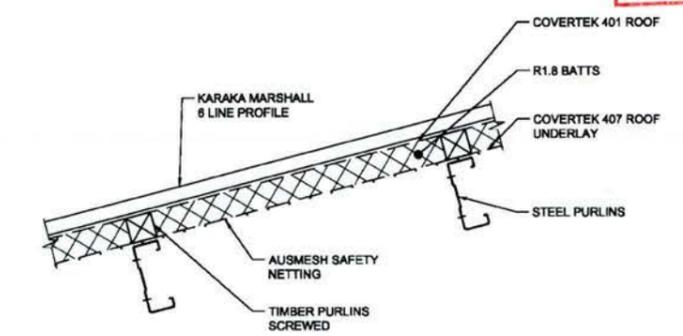

ROOF DETAIL  
 1:10 at A1  
 1:20 at A3

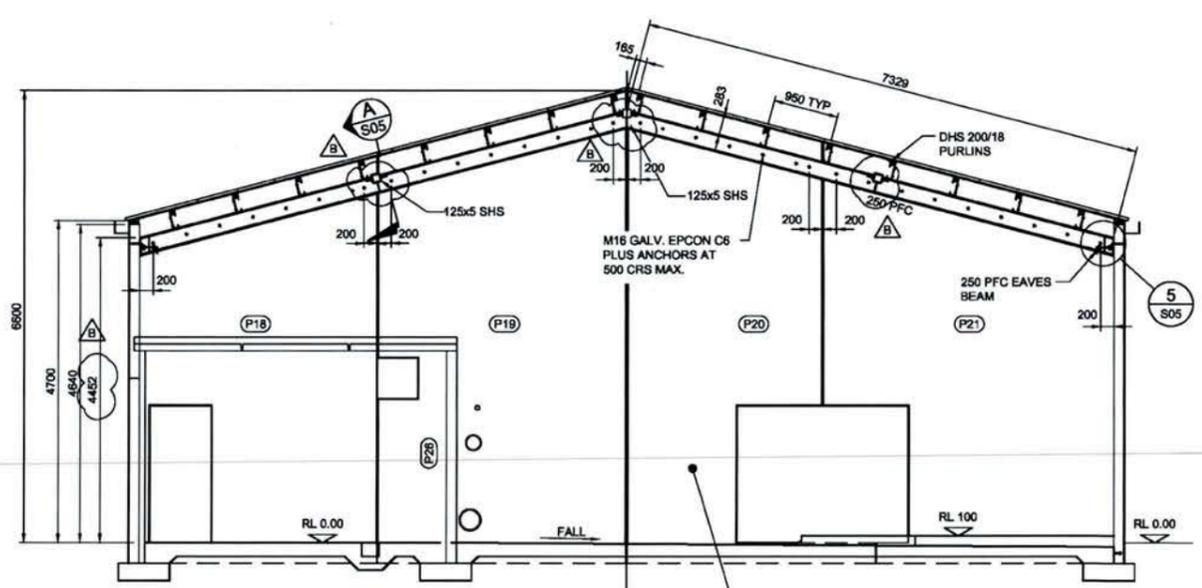

SECTION B  
 1:50 at A1  
 1:100 at A3

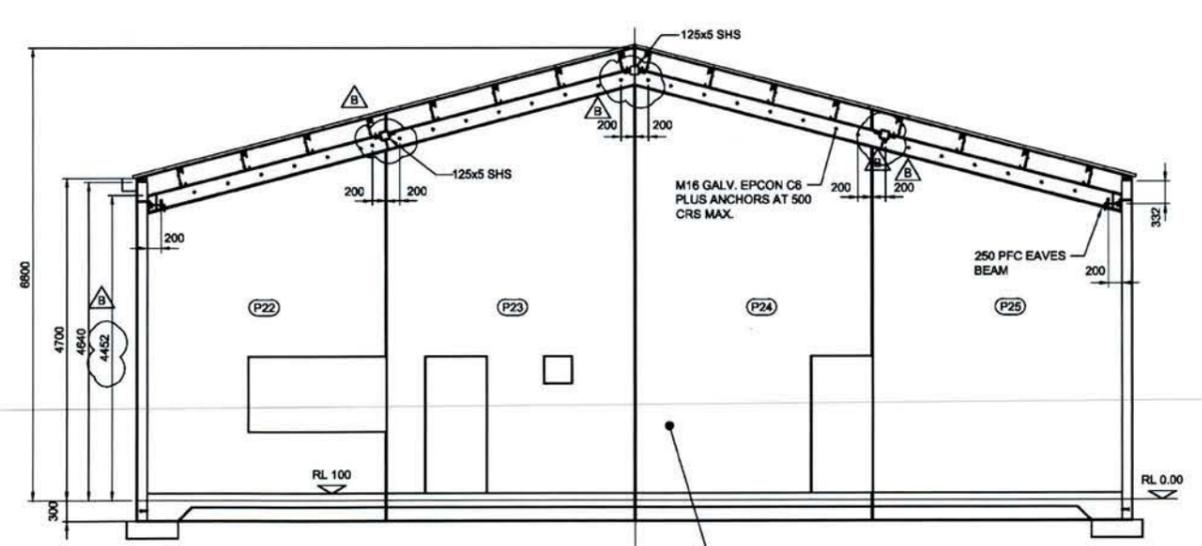

SECTION C  
 1:50 at A1  
 1:100 at A3

Rev No	REVISION DESCRIPTION	DRAWN	APPROVED	DATE
B	SHS RELOCATED	ITB	DK	11:6:21
A	ISSUED FOR CONSENT	ITB	DK	18:3:21
1	STEELWORK MODIFIED	ITB	DK	9:03:21
0	ISSUED FOR CONSENT / CONSTRUCTION	ITB	DK	1:12:20

	BY	DATE
DESIGNED	DK	10:20
DESIGN CHECK	DK	11:20
DRAWN	ITB	10:20
APPROVED		

**KENSINGTON CONSULTING**  
 Civil and Structural Engineers  
 03 218 7936 027 403 3773

**GORE WATER TREATMENT PLANT  
 UPGRADE - NEW BUILDING  
 SECTIONS**

STATUS <b>CONSTRUCTION</b>		
SCALE AT A1		
PROJECT NUMBER <b>20080</b>	DRAWING NUMBER <b>S03</b>	REV. <b>B</b>


ORIGINAL SIZE (A1) DO NOT SCALE

INFORMATION RECEIVED


ORIGINAL SIZE (A1) DO NOT SCALE  
 PLOT DATE 11-Jun-21

ORIGINAL SIZE (A1) DO NOT SCALE


ORIGINAL SIZE (A1) DO NOT SCALE

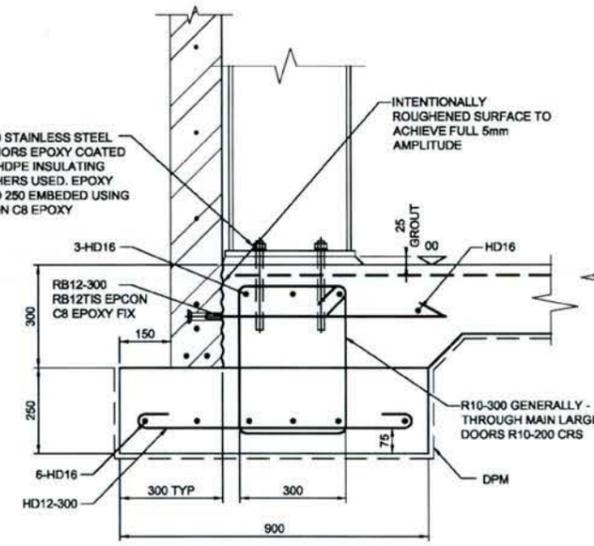


**SECTION D & D1**  
 1:10 at A1  
 1:20 at A3  
 SIMILAR EXCEPT NO PORTAL FRAME

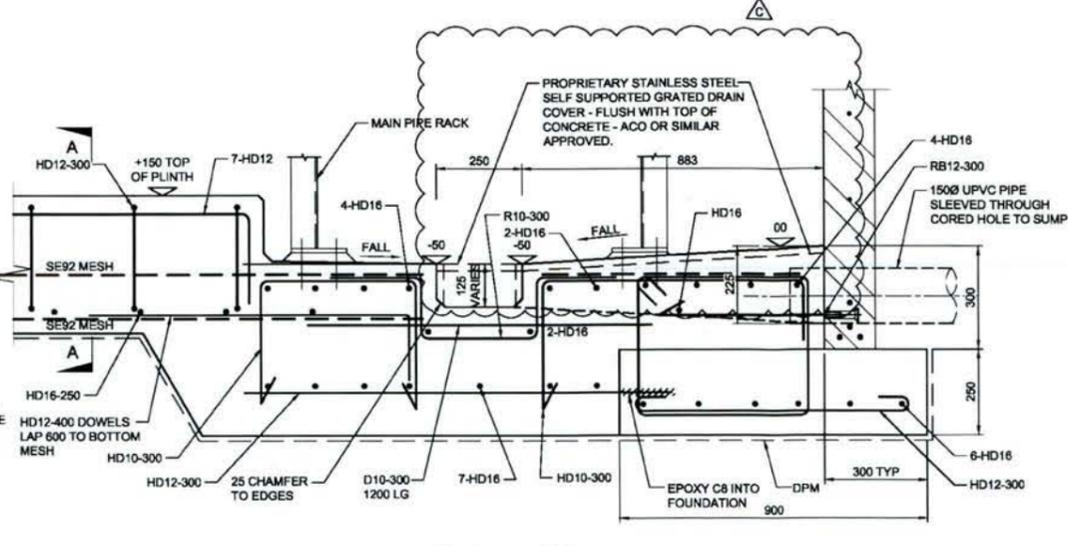


**SECTION E1**  
 1:10 at A1  
 1:20 at A3

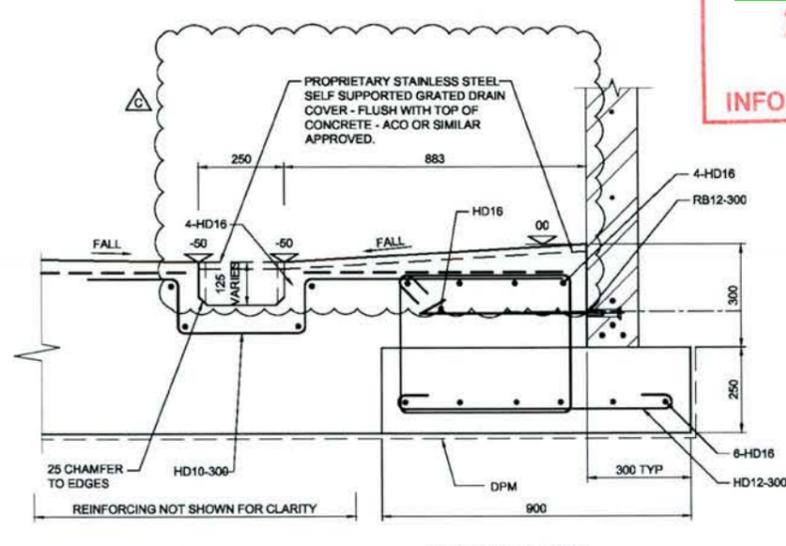


**SECTION E**  
 1:10 at A1  
 1:20 at A3

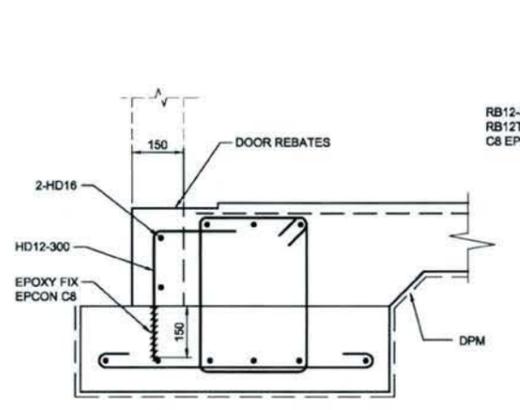


**SECTION AT LARGE DOOR OPENINGS**  
 1:10 at A1  
 1:20 at A3

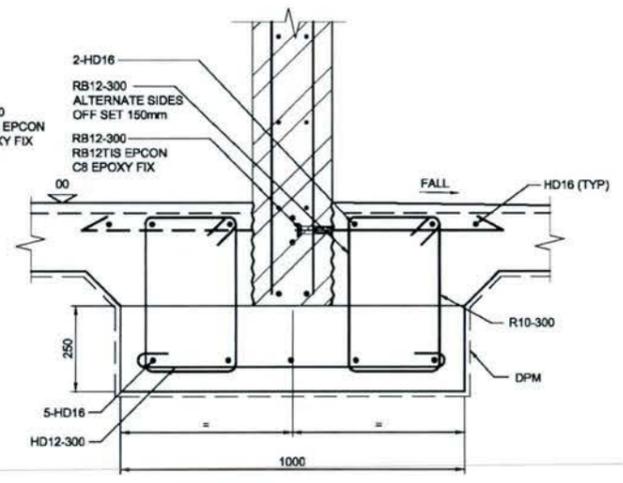


**SECTION H**  
 1:10 at A1  
 1:20 at A3

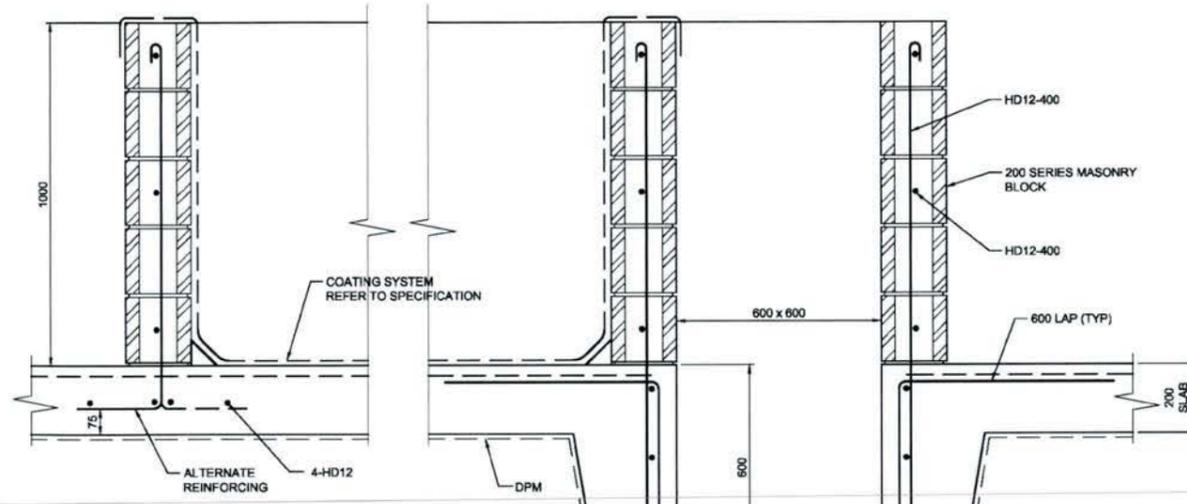


**SECTION F & F1**  
 1:10 at A1  
 1:20 at A3  
 SIMILAR FOR PIT

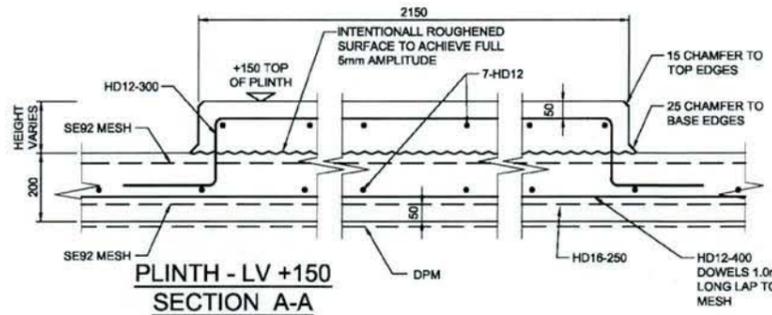


**SECTION A-A**  
 1:10 at A1  
 1:20 at A3

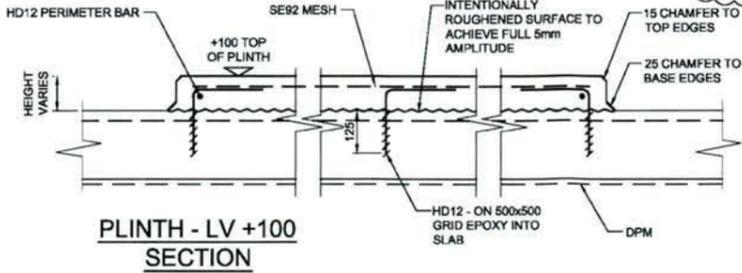

**SECTION**  
 1:10 at A1  
 1:20 at A3

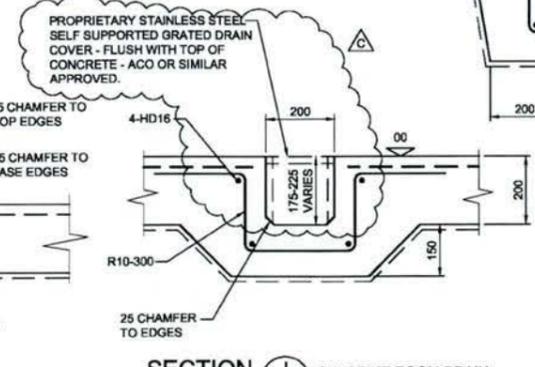

**SECTION I**  
 1:10 at A1  
 1:20 at A3  
 CHLORINE ROOM DRAIN

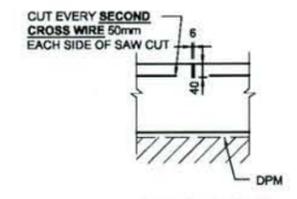

**SAW CUT JOINT**  
 SCALE 1:10

Rev No	REVISION DESCRIPTION	DRAWN	APPROVED	DATE
C	FLOOR DRAINAGE GRATING ADDED	ITB	DK	12-6-21
B	ANCHORS AND DRAIN MODIFIED	ITB	DK	12-5-21
A	ISSUED FOR CONSTRUCTION	ITB	DK	18-3-21
2	SECTION 'E' AND MODIFIED & EPOXY C8 ADDED	ITB	DK	9-3-21
1	150 UPVC ADDED	ITB	DK	16-12-20
0	ISSUED FOR CONSENT / CONSTRUCTION	ITB	DK	1-12-20


BY	DATE
DESIGNED	DK 10:20
DESIGN CHECK	DK 11:20
DRAWN	ITB 10:20
APPROVED	

**KENSINGTON CONSULTING**  
 Civil and Structural Engineers  
 03 218 7936 027 403 3773


**GORE WATER TREATMENT PLANT  
 UPGRADE - NEW BUILDING  
 SECTIONS AND DETAILS**

STATUS <b>CONSTRUCTION</b>		
SCALE AT A1	PROJECT NUMBER	DRAWING NUMBER
	20080	S04
		REV. C


Gore District Council  
 AMENDED / SUPPLEMENTAL  
 22 NOV 2023  
 INFORMATION RECEIVED

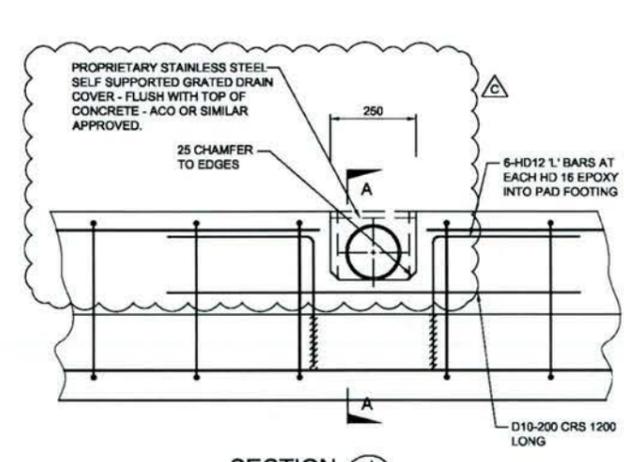


**SECTION J**  
 1:10 at A1  
 1:20 at A3

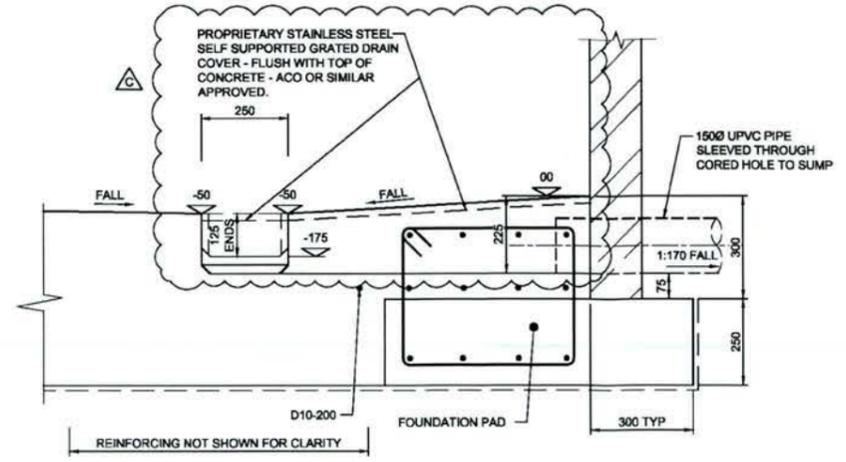


**SECTION A-A**  
 SCALE 1:10

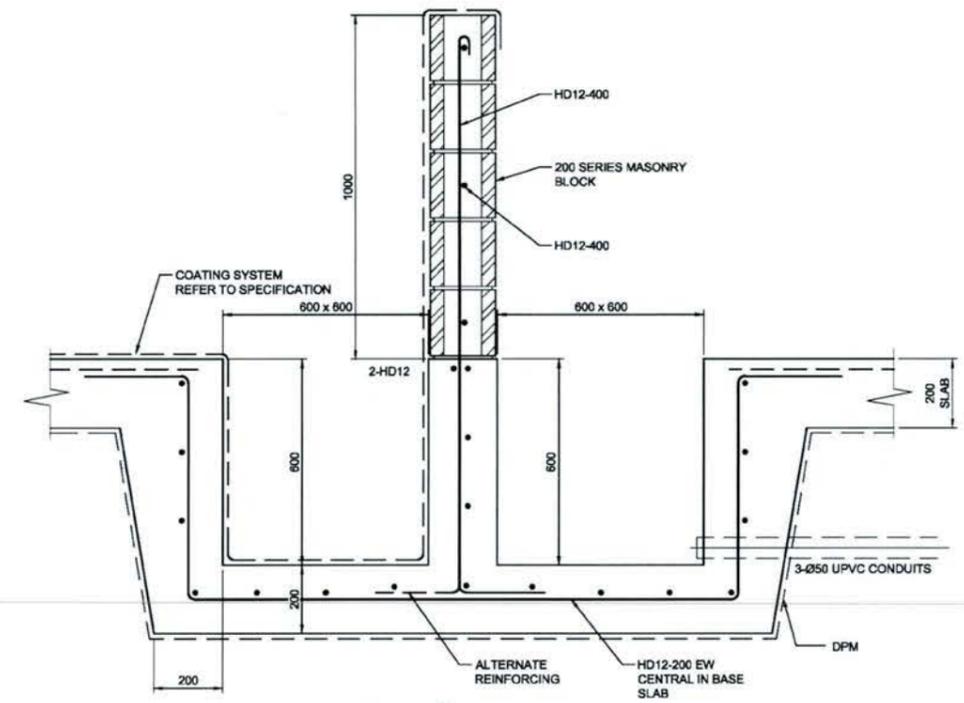

**SECTION G**  
 1:10 at A1  
 1:20 at A3

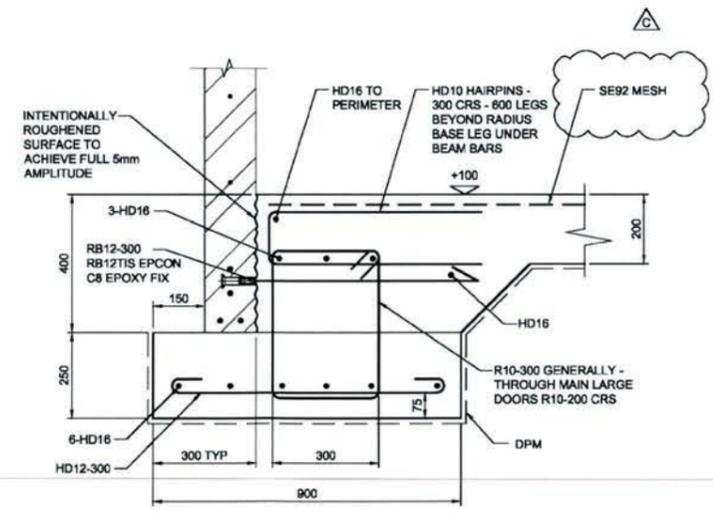

**SECTION D2**  
 1:10 at A1  
 1:20 at A3

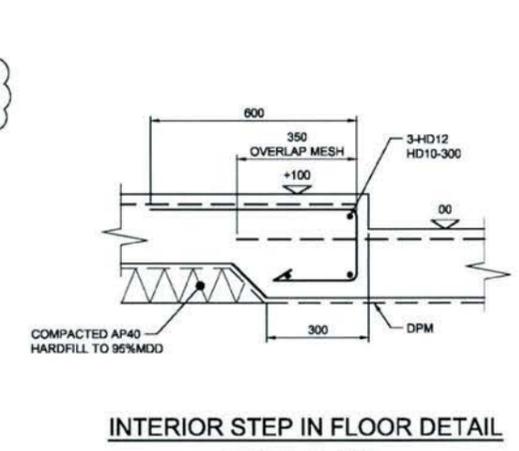

**SECTION J**  
 1:10 at A1  
 1:20 at A3

Rev No	REVISION DESCRIPTION	DRAWN	APPROVED	DATE
B	SECTIONS D2 & J ADDED	ITB	DK	13:5:21
A	ISSUED FOR CONSTRUCTION	ITB	DK	18:3:21

	BY	DATE
DESIGNED	DK	10:20
DESIGN CHECK	DK	11:20
DRAWN	ITB	10:20
APPROVED		

**KENSINGTON CONSULTING**  
 Civil and Structural Engineers  
 03 218 7936 027 403 3773


**GORE WATER TREATMENT PLANT  
 UPGRADE - NEW BUILDING  
 SECTIONS AND DETAILS**

STATUS		CONSTRUCTION
SCALE AT A1		
PROJECT NUMBER	DRAWING NUMBER	REV.
20080	S04B	B




Gore District Council  
 AMENDED / ~~REVISED~~  
 22 NOV 2023  
 INFORMATION RECEIVED

ORIGINAL SIZE (A1) DO NOT SCALE PLOT DATE 18-Mar-21

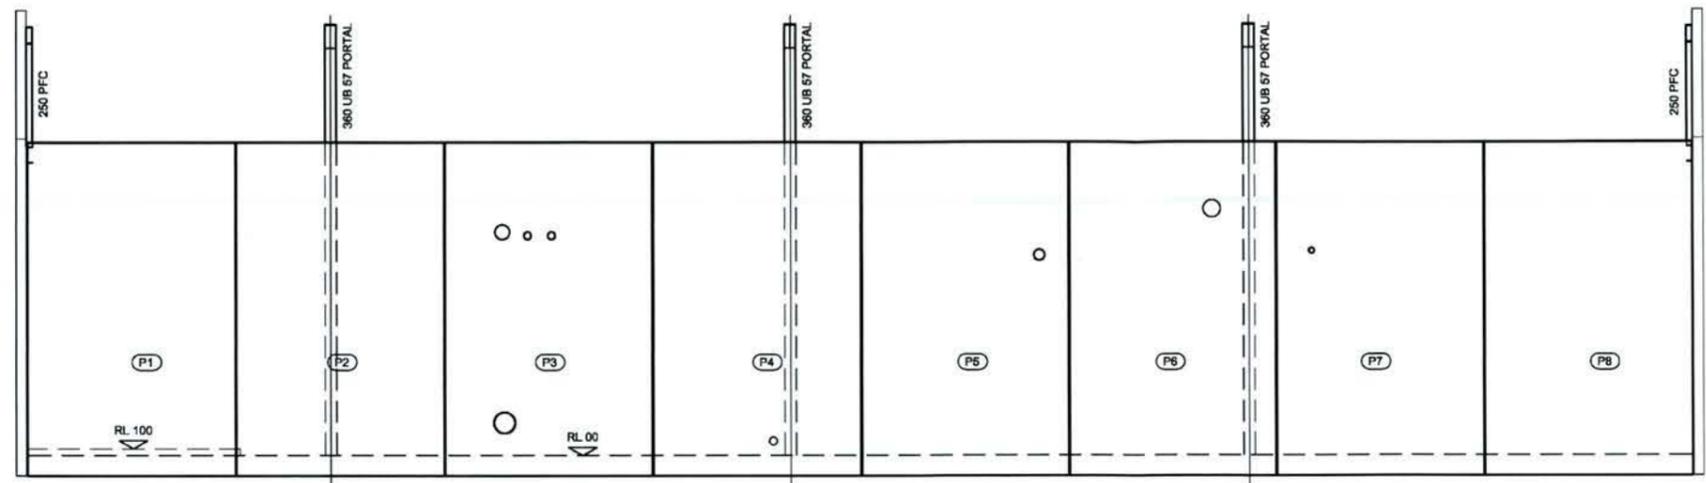

**SOUTH WALL ELEVATION** REFER TO S10 FOR PANEL DETAILS  
 1:50 at A1  
 1:100 at A3

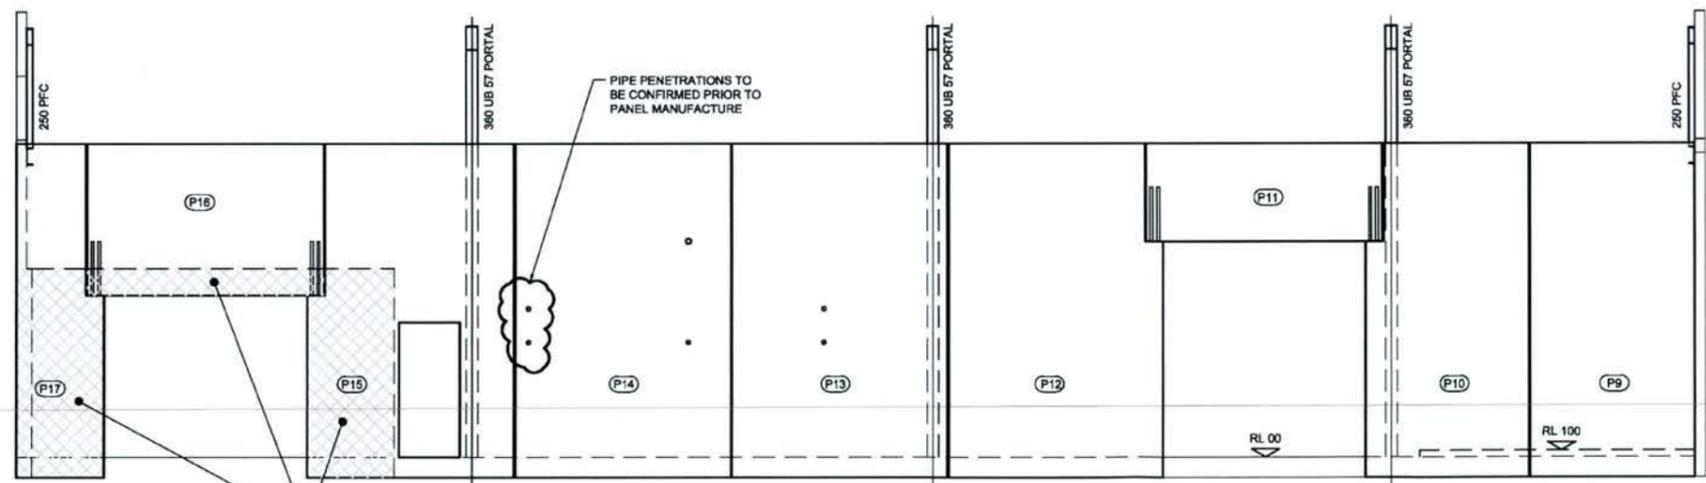


**NORTH WALL ELEVATION** REFER TO S06 FOR PANEL DETAILS  
 1:50 at A1  
 1:100 at A3

Rev No	ISSUED FOR CONSTRUCTION	ITB	DK	18:3:21
Rev No	REVISION DESCRIPTION	DRAWN	APPROVED	DATE

	BY	DATE
DESIGNED	DK	10:20
DESIGN CHECK	DK	11:20
DRAWN	ITB	10:20
APPROVED		

**KENSINGTON CONSULTING**  
 Civil and Structural Engineers  
 03 218 7936 027 403 3773

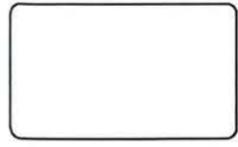


**GORE WATER TREATMENT PLANT  
 UPGRADE - NEW BUILDING  
 PRECAST PANELS  
 NORTH & SOUTH WALL ELEVATIONS**

STATUS <b>CONSTRUCTION</b>		
SCALE AT A1	DRAWING NUMBER	REV.
PROJECT NUMBER <b>20080</b>	<b>S06</b>	<b>A</b>

Gore District Council  
 AMENDED / ADDITIONAL  
 22 NOV 2023  
 INFORMATION RECEIVED



ORIGINAL SIZE (A1) DO NOT SCALE PLOT DATE 13-May-21

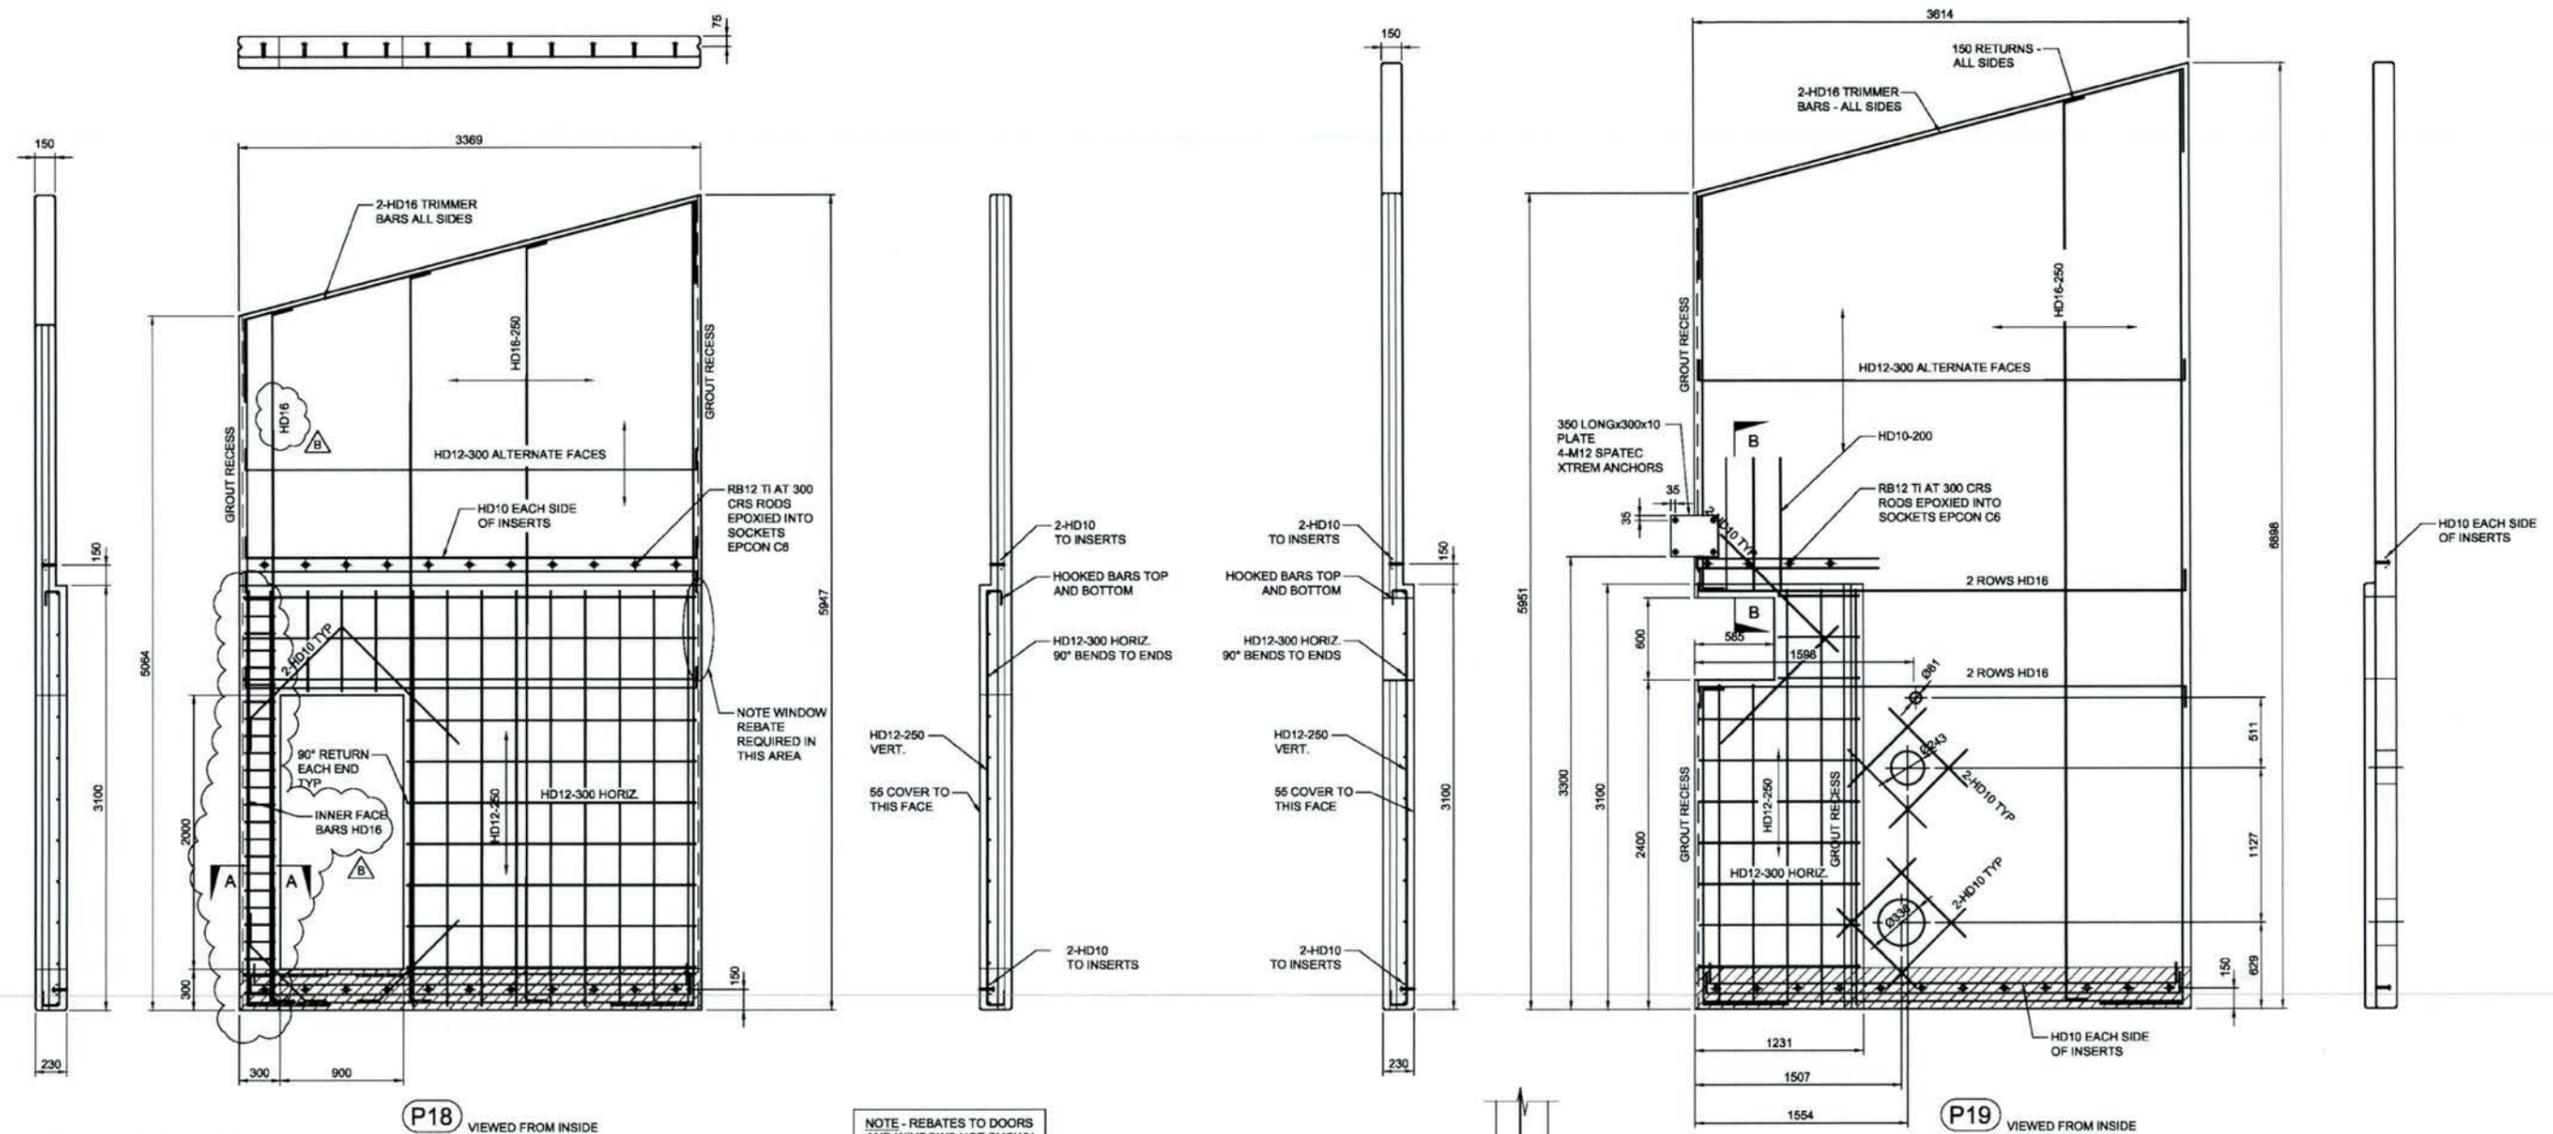

P18 VIEWED FROM INSIDE

P19 VIEWED FROM INSIDE

NOTE - REBATES TO DOORS AND WINDOWS NOT SHOWN - REFER TO S08 FOR DETAILS

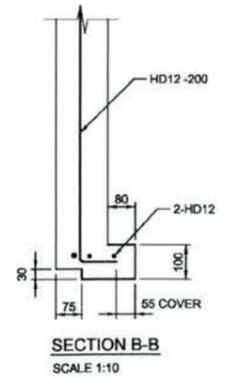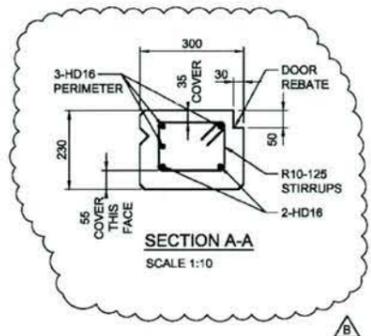

Rev No	REVISION DESCRIPTION	DRAWN	APPROVED	DATE
B	SECTION A-A MODIFIED	ITB	DK	12-5-21
A	ISSUED FOR CONSTRUCTION	ITB	DK	18-3-21
1	GENERAL ALTERATIONS	ITB	DK	15-3-21
0	ISSUED FOR CONSENT / CONSTRUCTION	ITB	DK	1-12-20


	BY	DATE
DESIGNED	DK	10-20
DESIGN CHECK	DK	11-20
DRAWN	ITB	10-20
APPROVED		

**KENSINGTON CONSULTING**  
 Civil and Structural Engineers  
 03 218 7936 027 403 3773


**GORE WATER TREATMENT PLANT  
 UPGRADE - NEW BUILDING  
 EAST WALL PRECAST PANELS  
 DETAILS**

STATUS	CONSTRUCTION		
SCALE AT A1	PROJECT NUMBER	DRAWING NUMBER	REV.
	20080	S07A	B

Gore District Council  
 AMENDED / ORIGINAL  
 22 NOV 2023  
 INFORMATION RECEIVED

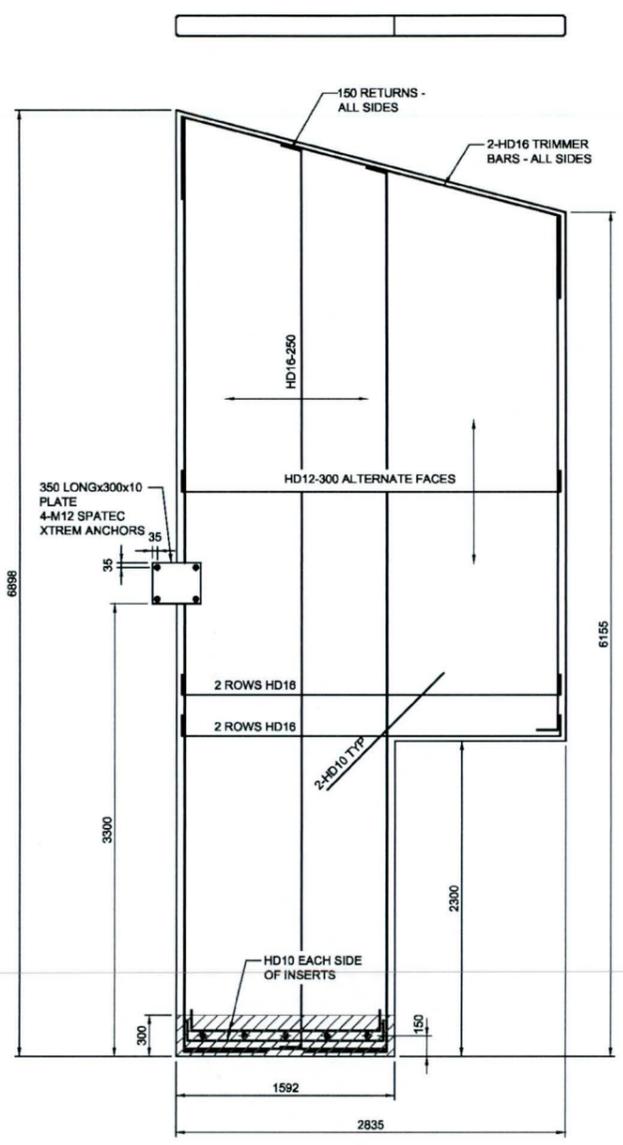

**P20**  
 VIEWED FROM INSIDE

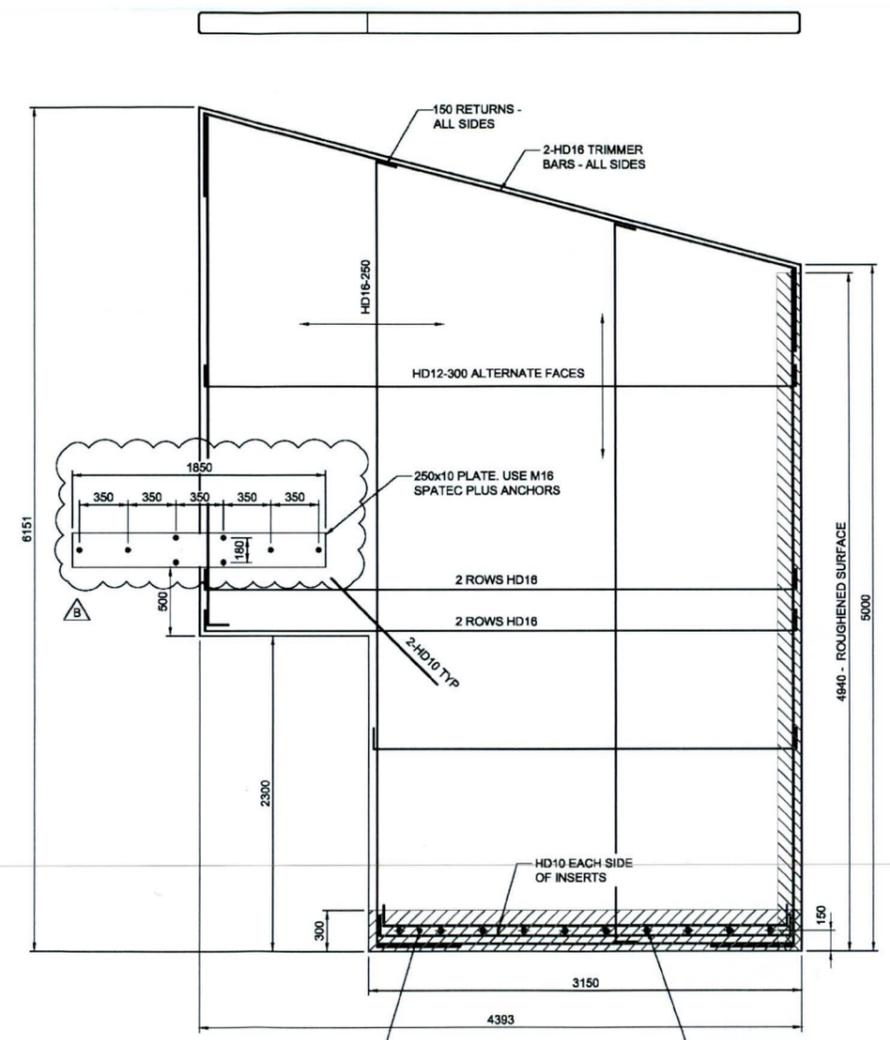

**P21**  
 VIEWED FROM INSIDE

**EAST WALL PANELS**  
 1:25 at A1  
 1:50 at A3

Rev No	REVISION DESCRIPTION	DRAWN	APPROVED	DATE
B	PLATE ADDED	ITB	DK	9-8-21
A	ISSUED FOR CONSTRUCTION	ITB	DK	18-3-21
1	GENERAL ALTERATIONS	ITB	DK	15-3-21
0	ISSUED FOR CONSENT / CONSTRUCTION	ITB	DK	1-12-20

	BY	DATE
DESIGNED	DK	10-20
DESIGN CHECK	DK	11-20
DRAWN	ITB	10-20
APPROVED		

**KENSINGTON CONSULTING**  
 Civil and Structural Engineers  
 03 218 7936 027 403 3773

**GORE WATER TREATMENT PLANT  
 UPGRADE - NEW BUILDING  
 EAST WALL PRECAST PANELS  
 DETAILS**

STATUS <b>CONSTRUCTION</b>		
SCALE AT A1		
PROJECT NUMBER <b>20080</b>	DRAWING NUMBER <b>S07B</b>	REV. <b>B</b>

ORIGINAL SIZE (A1) DO NOT SCALE PLOT DATE 14-Jun-21






ORIGINAL SIZE (A1) DO NOT SCALE

Gore District Council  
 AMENDED / MODIFIED  
 22 NOV 2023  
 INFORMATION RECEIVED

ORIGINAL SIZE (A1) DO NOT SCALE PLOT DATE 13-May-21

ORIGINAL SIZE (A1) DO NOT SCALE

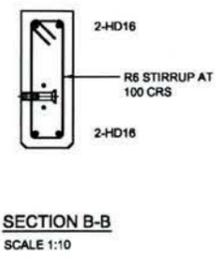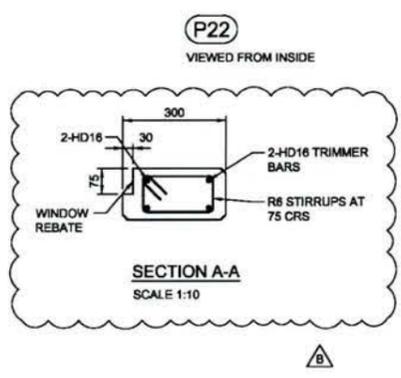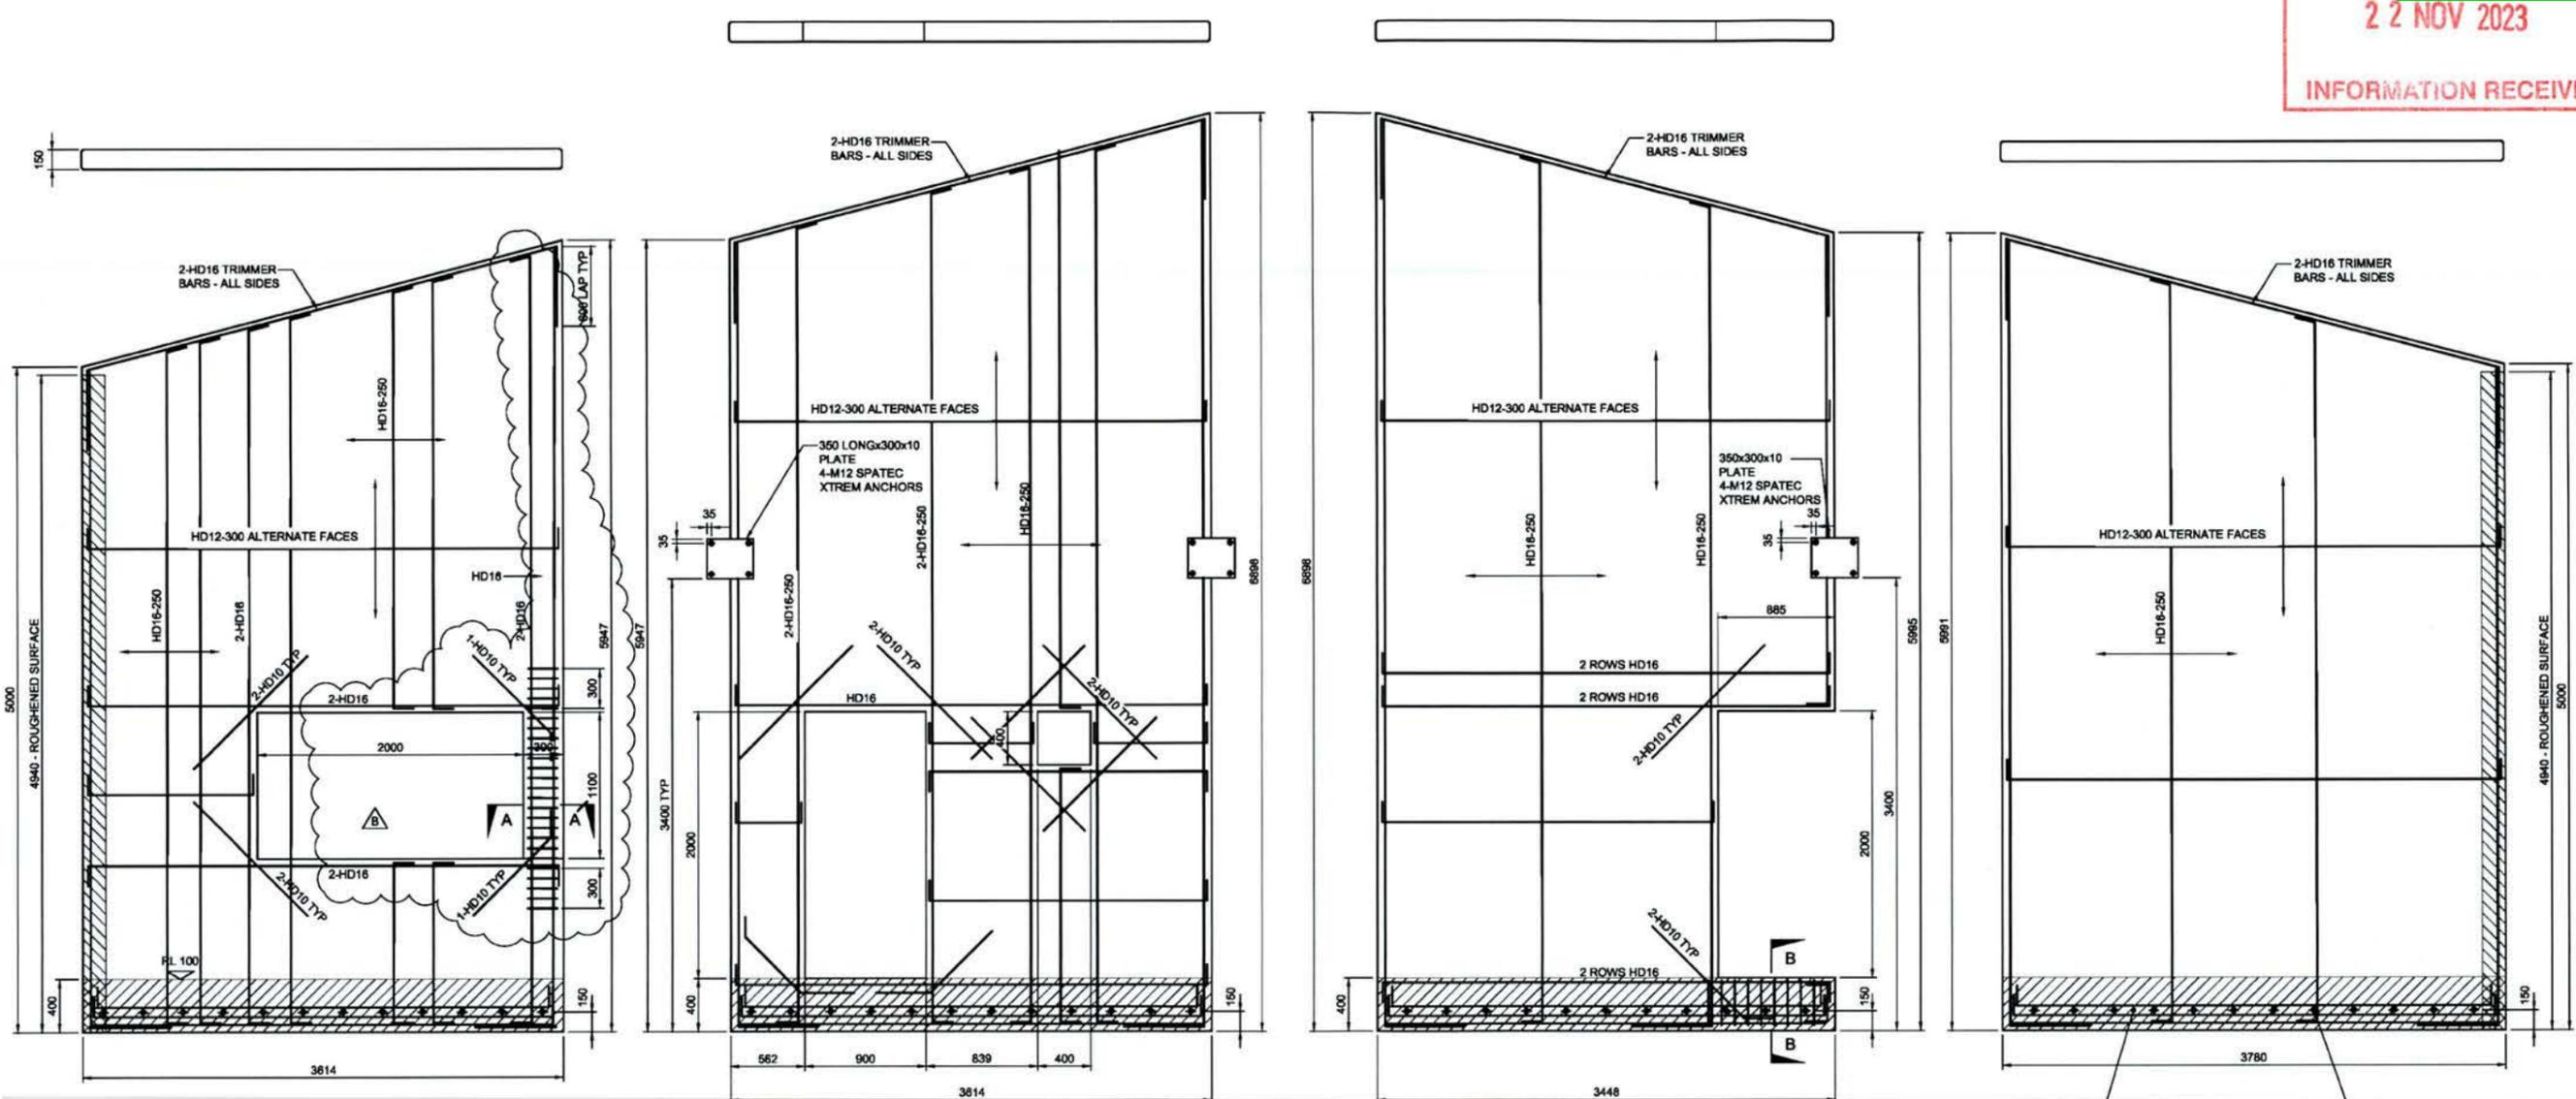

**WEST WALL PANELS**  
 1:25 at A1  
 1:50 at A3

HATCHED SURFACE RETARDED TO ACHIEVE FULL 5mm AMPLITUDE ROUGHNESS.  
 1 ROWS RB12T1 INSERTS AT 300 CRS CW ALL RODS TO BE EPOXIED AND SCREWED INTO SOCKETS - USE C8 OR APPROVED EQUAL. (TYPICAL ALL ANCHORAGES)

Rev No	REVISION DESCRIPTION	DRAWN	APPROVED	DATE
B	SECTION A-A MODIFIED	ITB	DK	12-5-21
A	ISSUED FOR CONSTRUCTION	ITB	DK	18-3-21
1	GENERAL ALTERATIONS	ITB	DK	15-3-21
0	ISSUED FOR CONSENT / CONSTRUCTION	ITB	DK	1-12-20

	BY	DATE
DESIGNED	DK	10-20
DESIGN CHECK	DK	11-20
DRAWN	ITB	10-20
APPROVED		


**KENSINGTON CONSULTING**  
 Civil and Structural Engineers  
 03 218 7936 027 403 3773

**GORE WATER TREATMENT PLANT  
 UPGRADE - NEW BUILDING  
 WEST WALL PRECAST PANELS  
 DETAILS**

STATUS <b>CONSTRUCTION</b>		
SCALE AT A1		
PROJECT NUMBER <b>20080</b>	DRAWING NUMBER <b>S08</b>	REV. <b>B</b>


Gore District Council  
 AMENDMENT NO. 1  
 22 NOV 2023  
 INFORMATION RECEIVED

ORIGINAL SIZE (A1) DO NOT SCALE

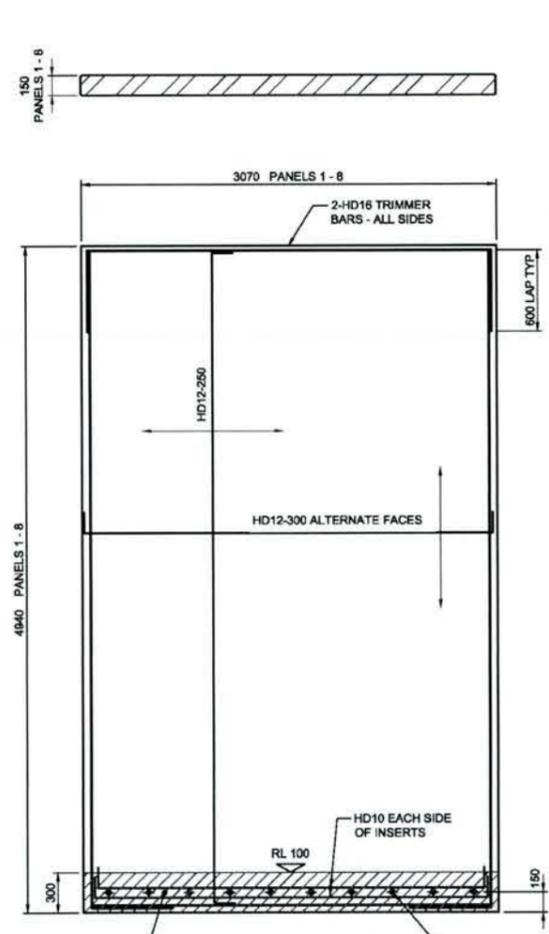


**P1 P2 P8**  
 VIEWED FROM INSIDE


REINFORCING THE SAME FOR PANELS 1 - 8

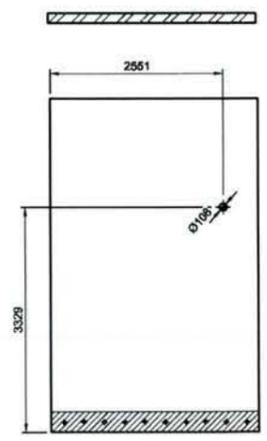


**P7**  
 VIEWED FROM INSIDE

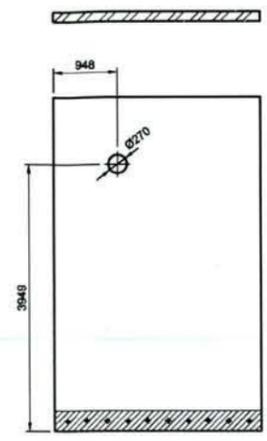


**P6**  
 VIEWED FROM INSIDE

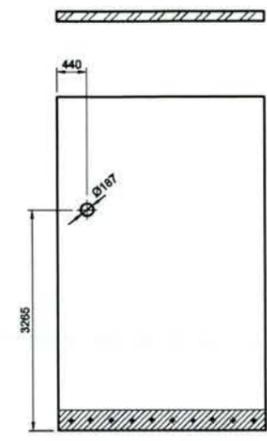


**P5**  
 VIEWED FROM INSIDE

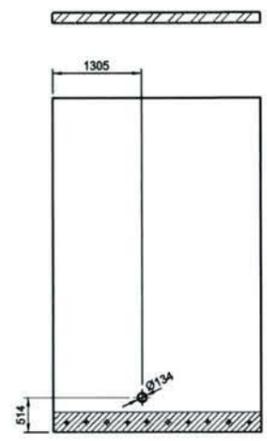


**P4**  
 VIEWED FROM INSIDE

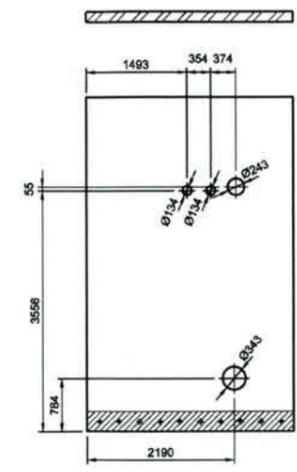

**P3**  
 VIEWED FROM INSIDE

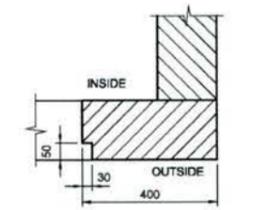


**DOOR JAMB DETAIL**  
 1:10 at A1  
 1:20 at A3

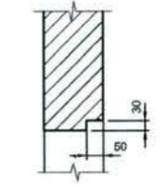


**DOOR HEAD DETAIL**  
 1:10 at A1  
 1:20 at A3


NOTE - ALL REBATE SIZING TO BE CONFIRMED WITH CONTRACTOR PRIOR TO PANEL MANUFACTURE.

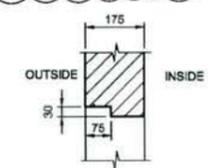


**WINDOW HEAD DETAIL**  
 1:10 at A1  
 1:20 at A3

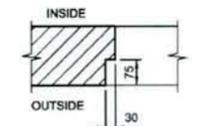

**WINDOW JAMB DETAIL**  
 1:10 at A1  
 1:20 at A3

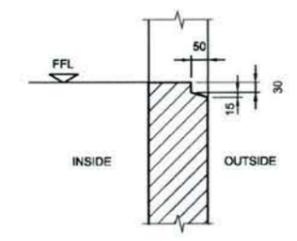


**DOOR SILL DETAIL**  
 1:10 at A1  
 1:20 at A3

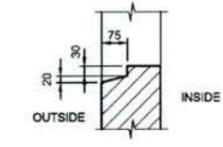

**WINDOW SILL DETAIL**  
 1:10 at A1  
 1:20 at A3

**SOUTH WALL PANELS**  
 1:50 at A1  
 1:100 at A3

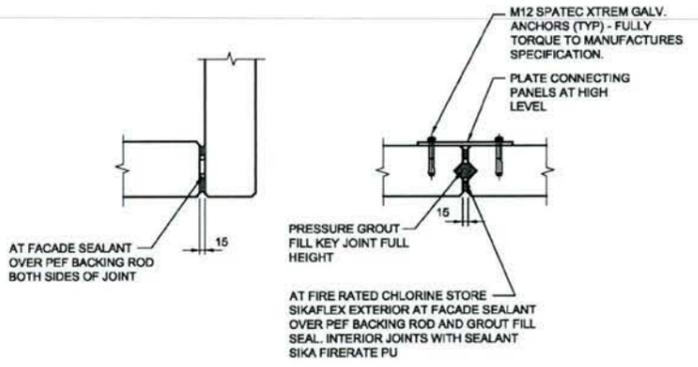

**PANEL - PANEL CONNECTIONS**

Rev No	REVISION DESCRIPTION	DRAWN	APPROVED	DATE
A	ISSUED FOR CONSTRUCTION	ITB	DK	18:3:21
1	GENERAL ALTERATIONS	ITB	DK	15:3:21
0	ISSUED FOR CONSENT / CONSTRUCTION	ITB	DK	1:12:20

	BY	DATE
DESIGNED	DK	10:20
DESIGN CHECK	DK	11:20
DRAWN	ITB	10:20
APPROVED		

**KENSINGTON CONSULTING**  
 Civil and Structural Engineers  
 03 218 7936 027 403 3773


**GORE WATER TREATMENT PLANT  
 UPGRADE - NEW BUILDING  
 SOUTH WALL PRECAST PANELS  
 AND PANEL CONNECTION DETAILS**

SCALE AT A1		
PROJECT NUMBER	DRAWING NUMBER	REV.
20080	S09	A


STATUS: CONSTRUCTION

Gore District Council  
 AMENDMENT / ADDITION  
 22 NOV 2023  
 INFORMATION RECEIVED


ORIGINAL SIZE (A1) DO NOT SCALE PLOT DATE 13-May-21

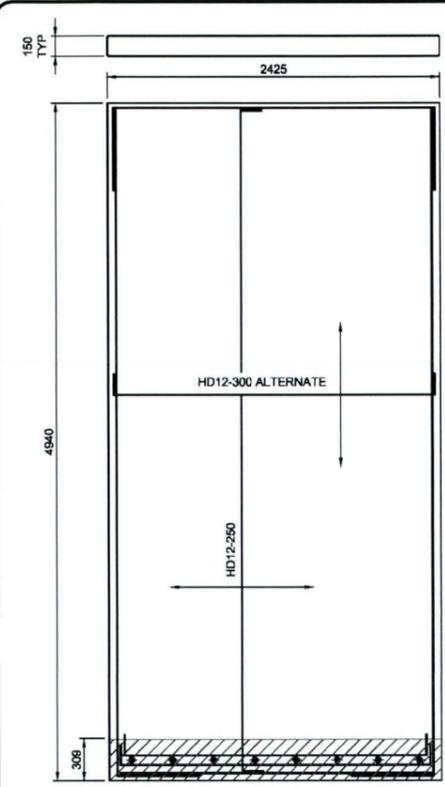


P9 VIEWED FROM INSIDE

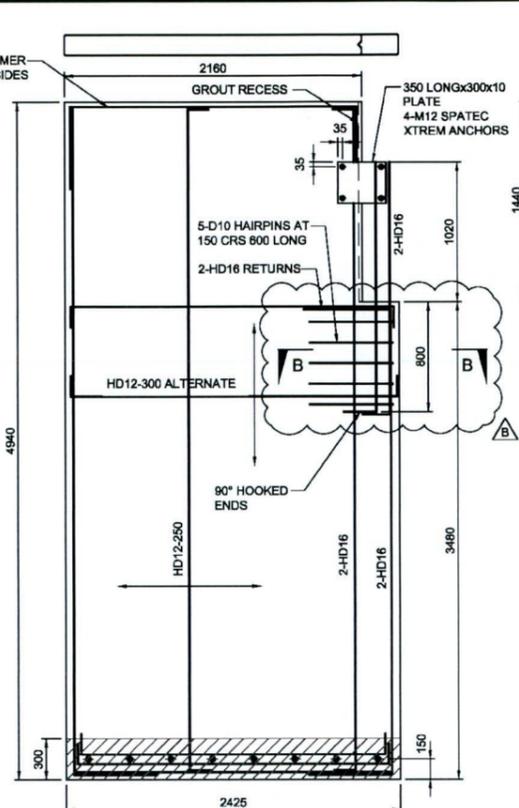


P10 VIEWED FROM INSIDE

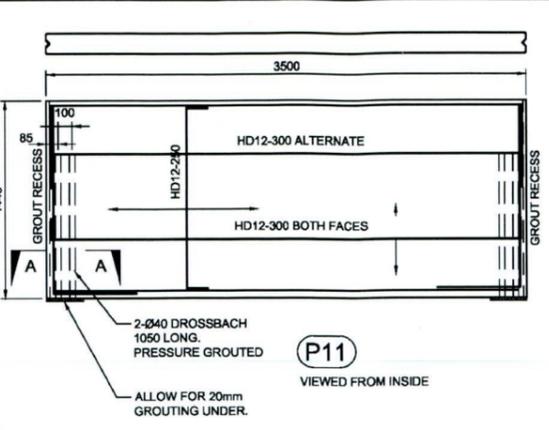


P11 VIEWED FROM INSIDE

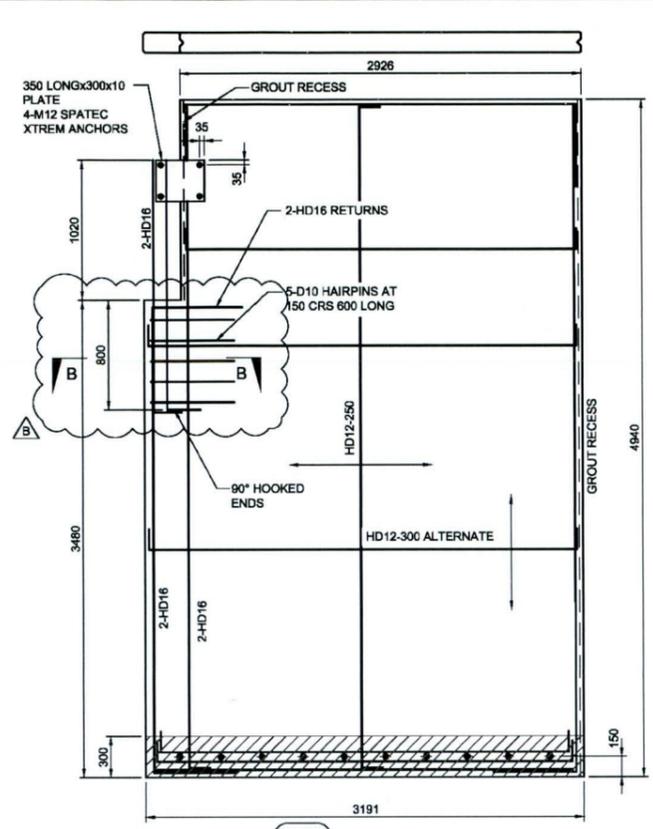


P12 VIEWED FROM INSIDE

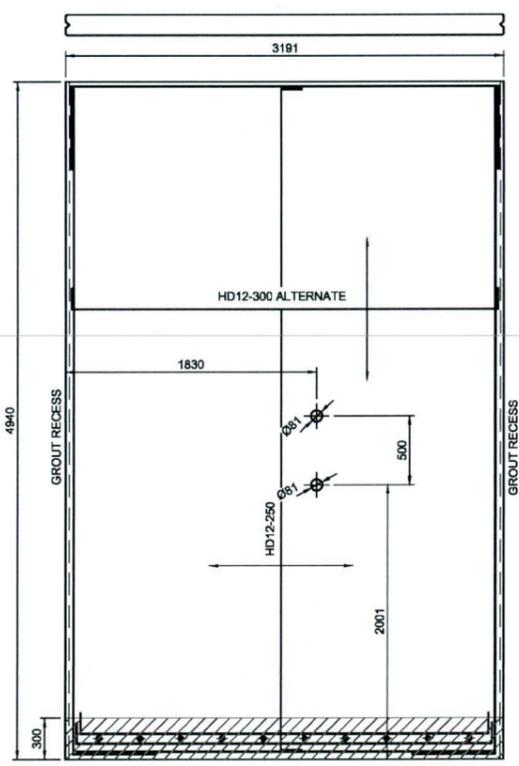


P13 VIEWED FROM INSIDE

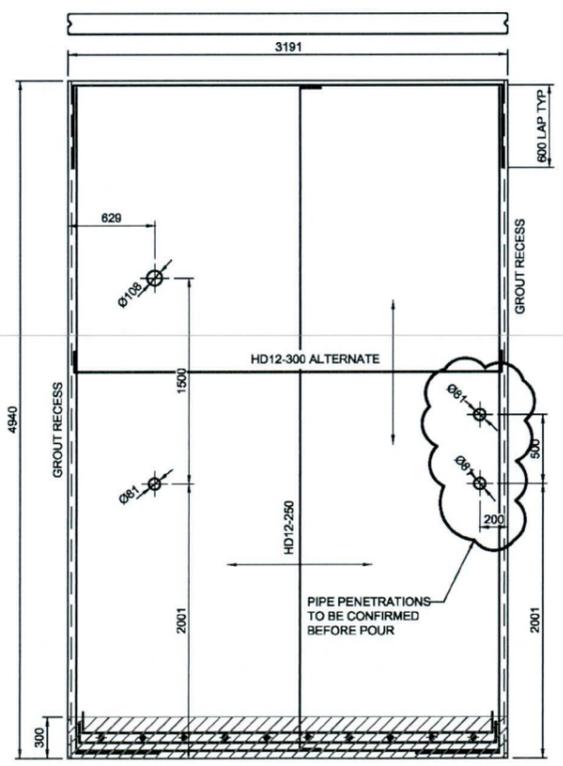

P14 VIEWED FROM INSIDE

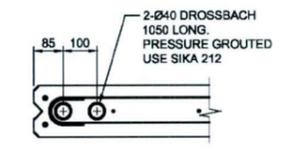

SECTION A-A  
SCALE 1:10

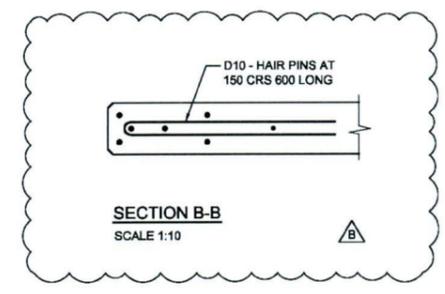

SECTION B-B  
SCALE 1:10

Rev No	REVISION DESCRIPTION	DRAWN	APPROVED	DATE
B	SECTION B-B ADDED	ITB	DK	12-5-21
A	ISSUED FOR CONSTRUCTION	ITB	DK	18-3-21
1	GENERAL ALTERATIONS	ITB	DK	15-3-21
0	ISSUED FOR CONSENT / CONSTRUCTION	ITB	DK	1-12-20


	BY	DATE
DESIGNED	DK	10-20
DESIGN CHECK	DK	11-20
DRAWN	ITB	10-20
APPROVED		

KENSINGTON CONSULTING  
 Civil and Structural Engineers  
 03 218 7936 027 403 3773


GORE WATER TREATMENT PLANT  
 UPGRADE - NEW BUILDING  
 NORTH WALL PRECAST PANELS  
 DETAILS

STATUS CONSTRUCTION		
SCALE AT A1		
PROJECT NUMBER 20080	DRAWING NUMBER S10	REV. B


Gore District Council  
 AMENDMENT 1 / ORIGINAL  
 22 NOV 2023  
 INFORMATION RECEIVED

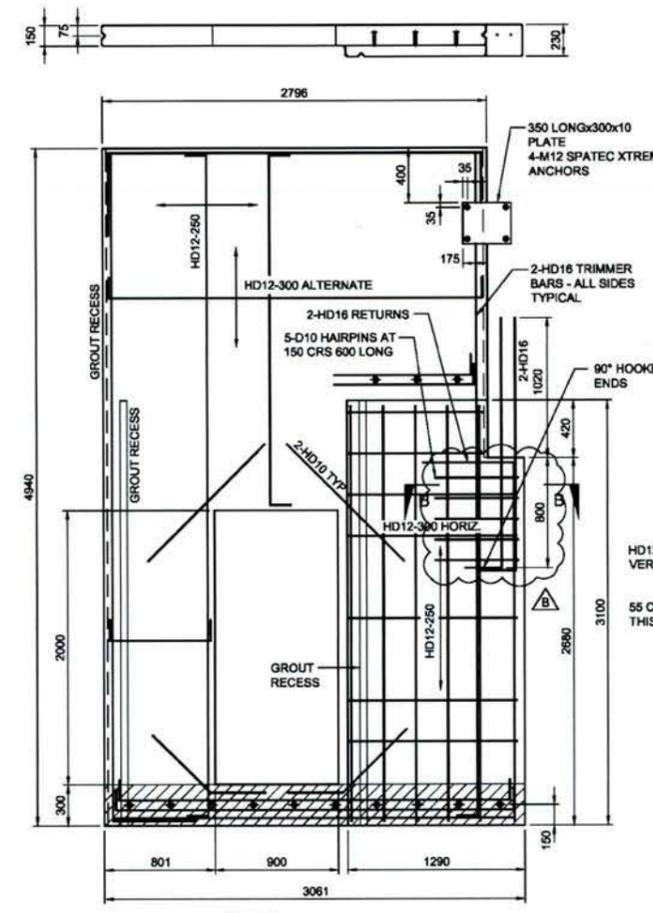


P15 VIEWED FROM INSIDE

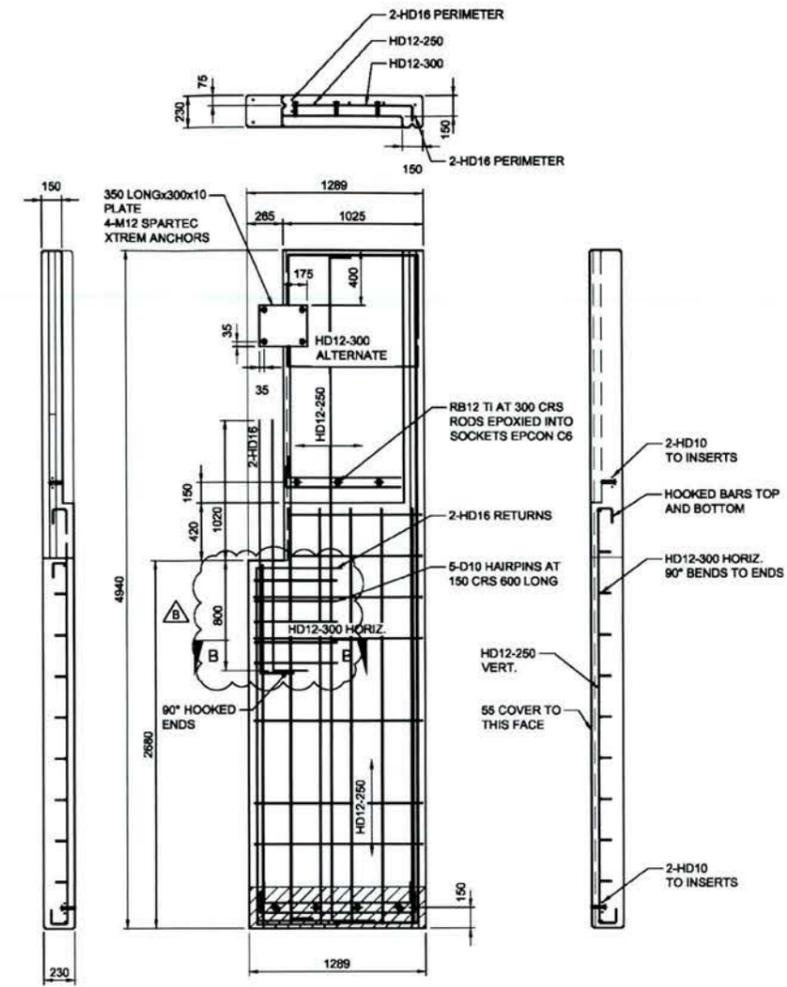


P17 VIEWED FROM INSIDE

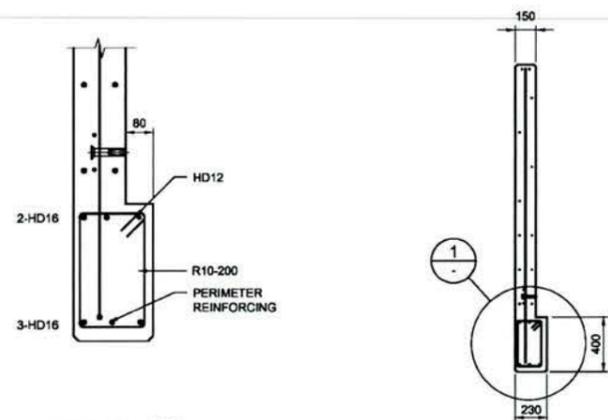

DETAIL 1  
 1:10 at A1  
 1:20 at A3

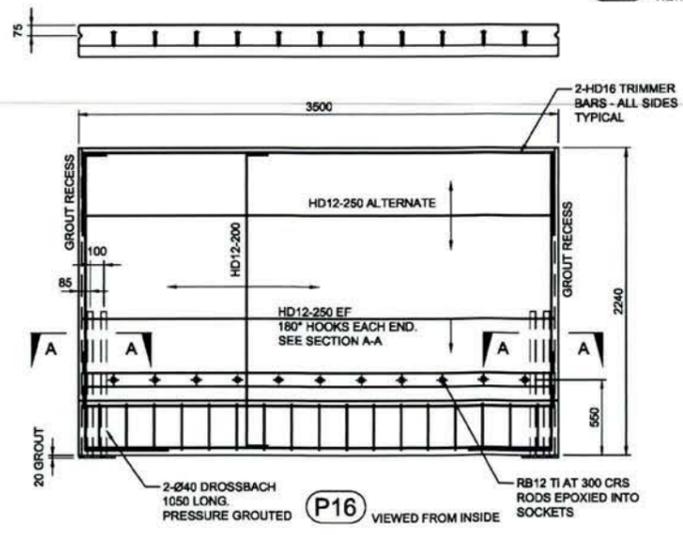

P16 VIEWED FROM INSIDE

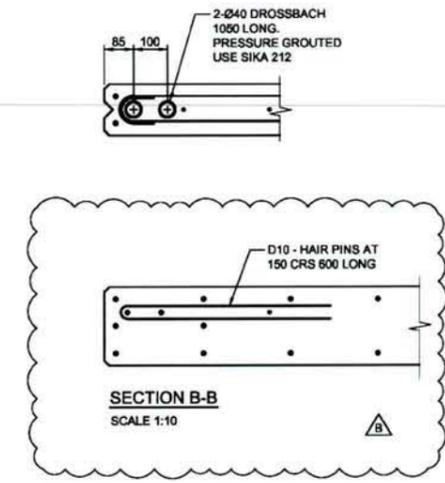

SECTION B-B  
 SCALE 1:10

Rev No	REVISION DESCRIPTION	DRAWN	APPROVED	DATE
12:5:21				
B	SECTION	B-B ADDED	ITB	DK
A	ISSUED FOR CONSTRUCTION	ITB	DK	18:3:21
1	GENERAL ALTERATIONS	ITB	DK	15:3:21
0	ISSUED FOR CONSENT / CONSTRUCTION	ITB	DK	1:12:20

	BY	DATE
DESIGNED	DK	10:20
DESIGN CHECK	DK	11:20
DRAWN	ITB	10:20
APPROVED		

KENSINGTON CONSULTING  
 Civil and Structural Engineers  
 03 218 7936 027 403 3773

GORE WATER TREATMENT PLANT  
 UPGRADE - NEW BUILDING  
 NORTH WALL PRECAST PANELS  
 DETAILS


STATUS CONSTRUCTION		
SCALE AT A1		
PROJECT NUMBER 20080	DRAWING NUMBER S11	REV. B

ORIGINAL SIZE (A1) DO NOT SCALE PLOT DATE 13-May-21


200 mm  
150  
100  
80  
60  
40  
20

ORIGINAL SIZE (A1) DO NOT SCALE

AMF APPROVED  
 22 NOV 2023  
 INFORMATION RECEIVED

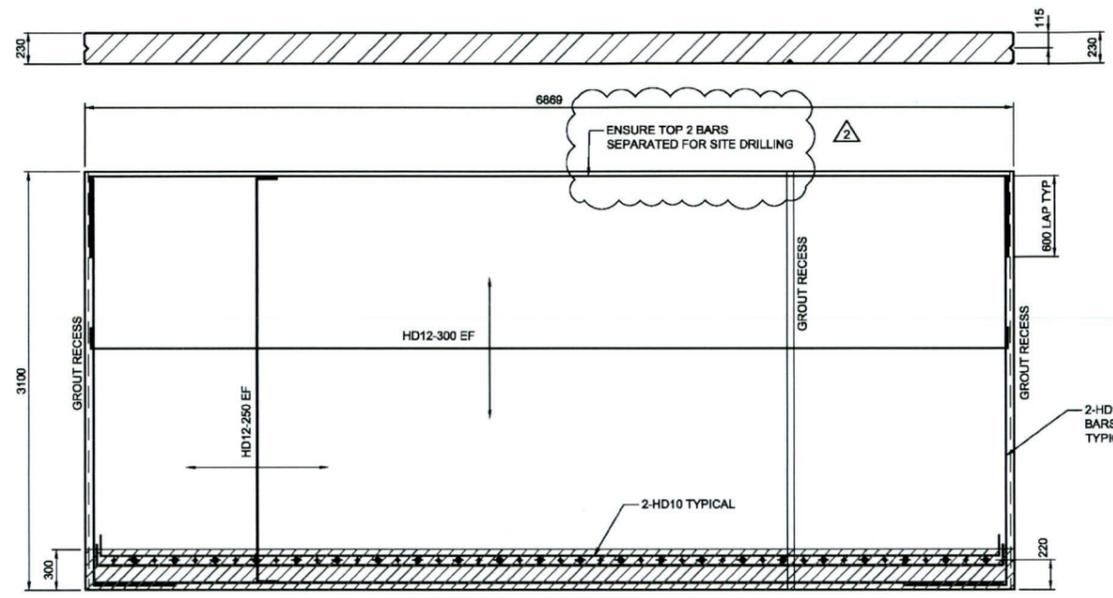


P26

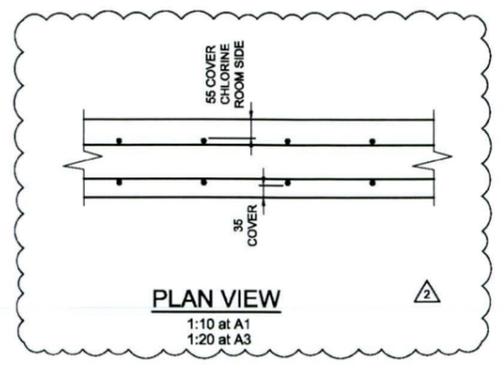


PLAN VIEW

1:10 at A1  
 1:20 at A3

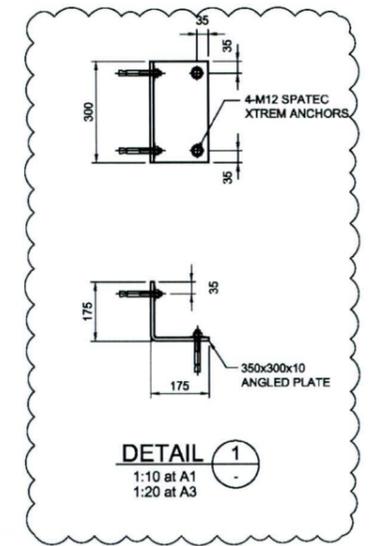


DETAIL 1

1:10 at A1  
 1:20 at A3

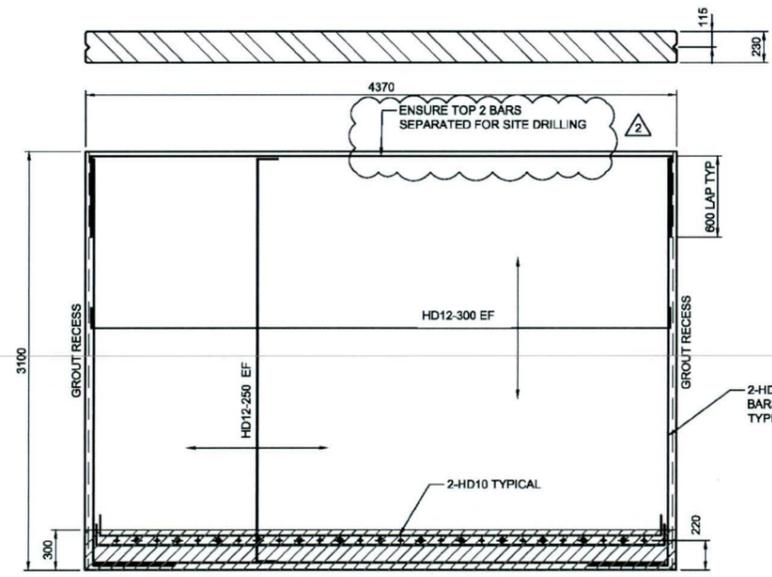

P27 VIEWED FROM INSIDE

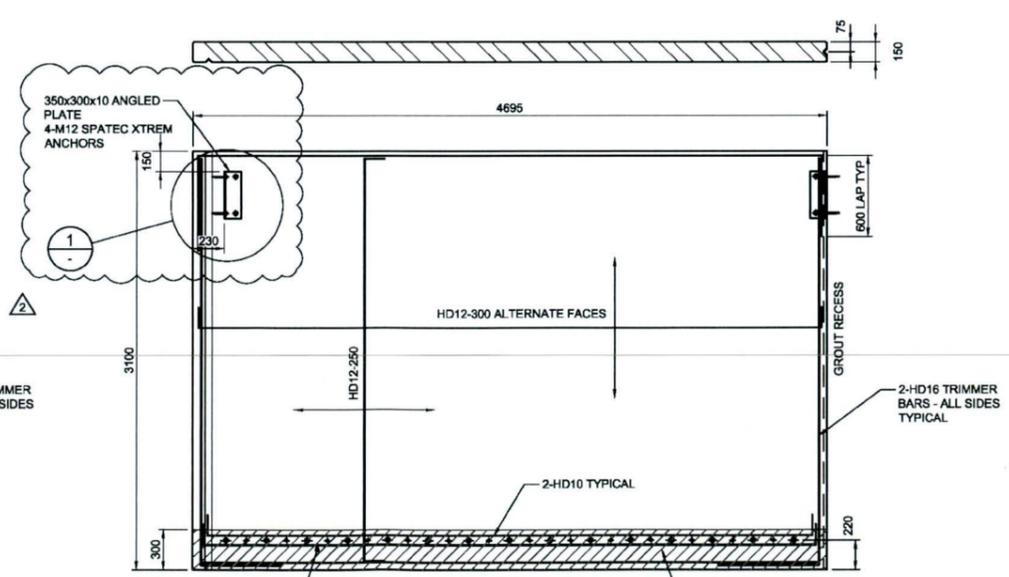

P28 VIEWED FROM INSIDE

HATCHED SURFACE  
 RETARDED TO ACHIEVE  
 FULL 5mm AMPLITUDE  
 ROUGHNESS.

1 ROW RB12TI INSERTS AT 150 CRS  
 - OFFSET EACH SIDE CW ALL RODS  
 TO BE GROUTED AS WELL AS  
 SCREWED INTO SOCKETS - USE C6  
 OR APPROVED EQUAL. (TYPICAL  
 ALL ANCHORAGES)

Rev No	REVISION DESCRIPTION	DRAWN	APPROVED	DATE
A	ISSUED FOR CONSTRUCTION	ITB	DK	18:3:21
2	GENERAL ALTERATIONS	ITB	DK	16:3:21
1	PLATES ADDED TO PANEL P28	ITB	DK	4:12:20
0	ISSUED FOR CONSENT / CONSTRUCTION	ITB	DK	1:12:20

	BY	DATE
DESIGNED	DK	10:20
DESIGN CHECK	DK	11:20
DRAWN	ITB	10:20
APPROVED		


KENSINGTON CONSULTING  
 Civil and Structural Engineers  
 03 218 7936 027 403 3773

GORE WATER TREATMENT PLANT  
 UPGRADE - NEW BUILDING  
 INTERNAL PRECAST PANELS  
 DETAILS


STATUS CONSTRUCTION		
SCALE AT A1	DRAWING NUMBER	REV.
PROJECT NUMBER 20080	S12	A

ORIGINAL SIZE (A1) DO NOT SCALE PLOT DATE 18-Mar-21


Gore District Council  
 AMENDMENT  
 22 NOV 2023  
 INFORMATION RECEIVED

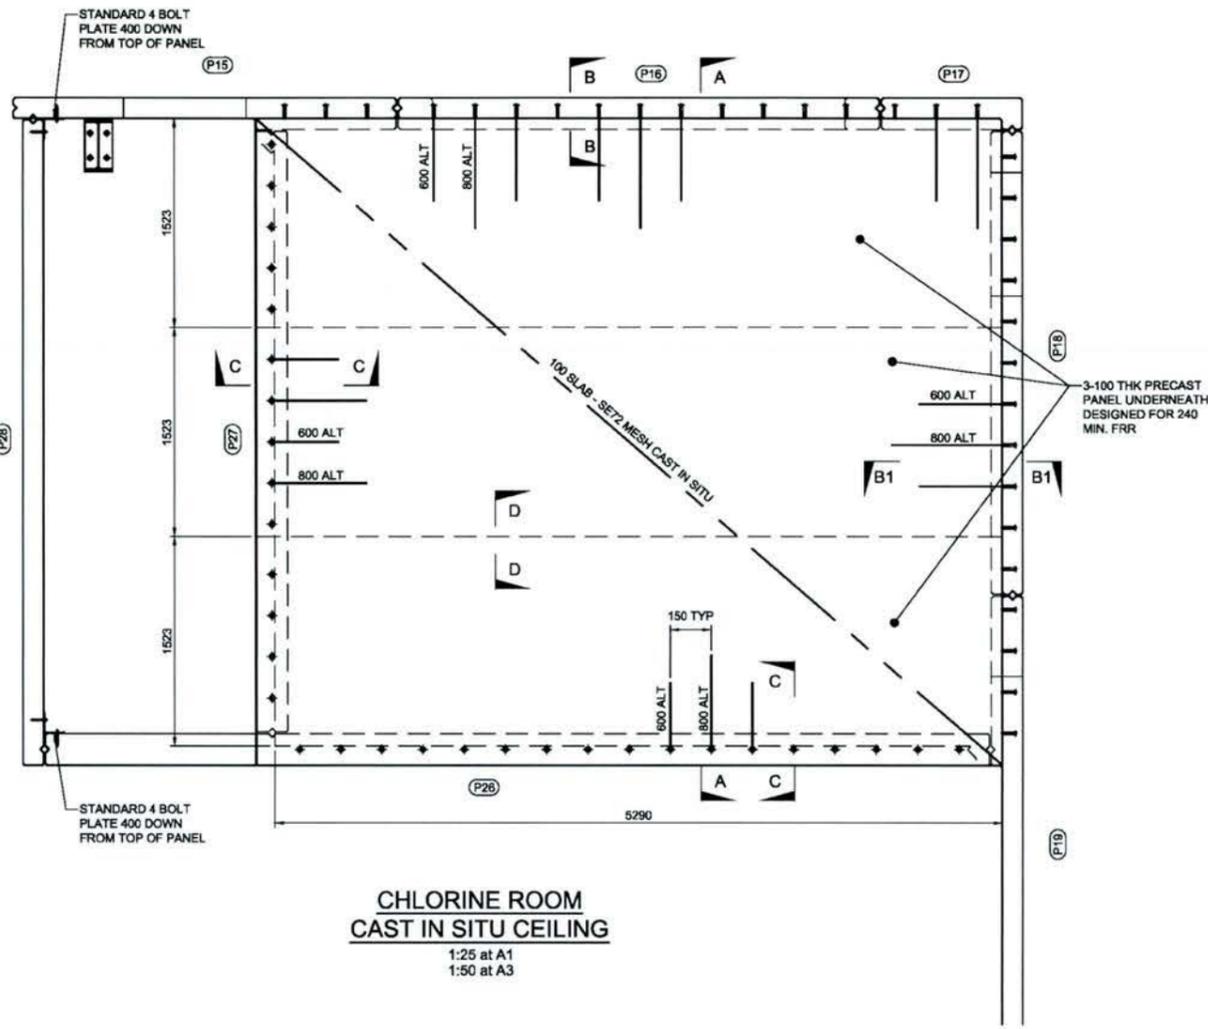


**CHLORINE ROOM  
 CAST IN SITU CEILING**  
 1:25 at A1  
 1:50 at A3

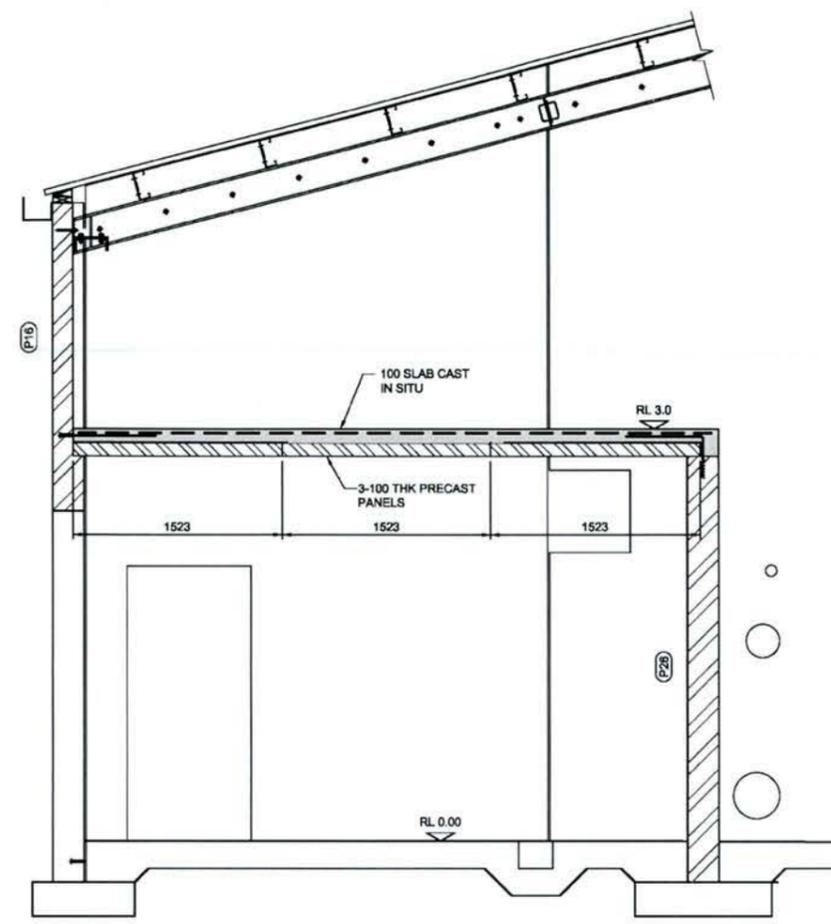

**SECTION A-A**  
 SCALE 1:10

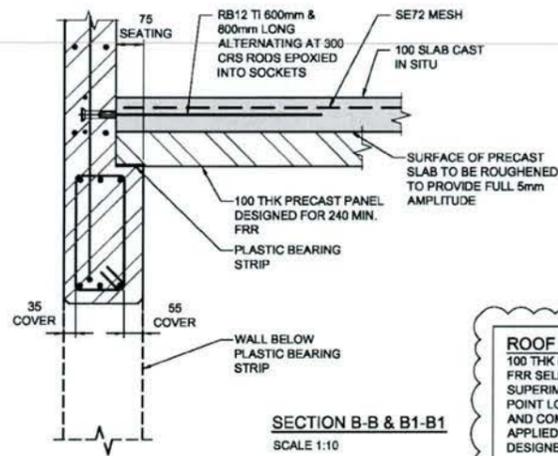

**SECTION B-B & B1-B1**  
 SCALE 1:10

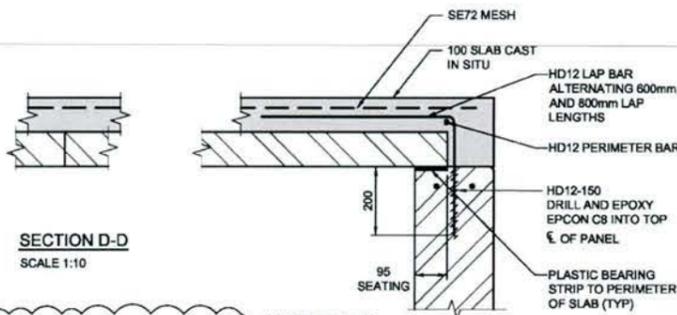

**SECTION D-D**  
 SCALE 1:10

**SECTION C-C**  
 SCALE 1:10

**ROOF SLAB DESIGN LOADS**  
 100 THK PRECAST PANEL DESIGNED FOR 240 MIN. FRR SELF WEIGHT INCLUDING TOPPING.  
 SUPERIMPOSED LIVE LOAD - 3KPA UDL AND 3.5KN POINT LOAD. APPROPRIATE DESIGN FACTORS AND COMBINATION OF LOADING SHALL BE APPLIED TO THESE LOADS. DESIGNER TO PROVIDE PS1.

Rev No	REVISION DESCRIPTION	DRAWN	APPROVED	DATE
C	INCREASED POINT LOADING	ITB	DK	11-8-21
B	DESIGN LOADS MODIFIED	ITB	DK	12-5-21
A	ISSUED FOR CONSTRUCTION	ITB	DK	18-2-21
1	GENERAL ALTERATIONS	ITB	DK	15-3-21
0	ISSUED FOR CONSENT / CONSTRUCTION	ITB	DK	2-12-20

	BY	DATE
DESIGNED	DK	10-20
DESIGN CHECK	DK	11-20
DRAWN	ITB	10-20
APPROVED		

**KENSINGTON CONSULTING**  
 Civil and Structural Engineers  
 03 218 7936 027 403 3773

**GORE WATER TREATMENT PLANT  
 UPGRADE - NEW BUILDING  
 CHLORINE ROOM CEILING  
 PLAN AND SECTIONS**

STATUS	CONSTRUCTION	
SCALE AT A1	PROJECT NUMBER	DRAWING NUMBER
	20080	S13
		REV. C

ORIGINAL SIZE (A1) DO NOT SCALE PLOT DATE 11-Jun-23

20 JAN 2021  
1:28 PM

## Caroline Shearing

**From:** Hashem Ramezan-zadeh <HRamezan-zadeh@goredc.govt.nz>  
**Sent:** Wednesday, 20 January 2021 1:28 PM  
**To:** Caroline Shearing  
**Cc:** Russell Paterson  
**Subject:** Gore Water Treatment Plant Upgrade - Building Consent Exemption  
**Attachments:** Mimecast Large File Send Instructions

I'm using Mimecast to share large files with you. Please see the attached instructions.

Hi Caroline,

Please find attached the application for the building consent exemption for Gore water treatment plant (WTP). I have attached the specifications, PS1 and drawings. I will submit the test plan (ITP) and PS2, shortly.

I appreciate if you would register the application and organise to process it as soon as possible.

Thanks and regards.  
Hashem

**Hashem Ramezan-zadeh** | Project Manager Infrastructure  
**T:** 03 209 0330 | **DDI:** 03 748 0102 | **M:** 021 195 7018  
**E:** hramezan-zadeh@goredc.govt.nz | **W:** www.goredc.govt.nz  
Gore District Council, 29 Bowler Avenue, PO Box 8, Gore, 9740

**GO RURAL**  
DISTRICT COUNCIL  
**RE CITY**  
**LIVING**



### Disclaimer

The information contained in this communication from Gore District Council is confidential. It is intended solely for use by the recipient and others authorized to receive it. If you are not the recipient, you are hereby notified that any disclosure, copying, distribution or taking action in relation of the contents of this information is strictly prohibited and may be unlawful.



**GORE DISTRICT COUNCIL**  
 APPROVED Schedule 1 Item 2  
 Gore District Council  
 Exemption # Schedule 1 (2)  
 Date: 30 January 2024  
 Page: 29 of 70

**PRODUCER STATEMENT – PS1 – DESIGN**

(Guidance notes on the use of this form are printed on page 2)

ISSUED BY:.....KENSINGTON CONSULTING LTD.....  
 (Design Firm)

TO:.. Gore District Council.....  
 (Owner/~~Developer~~)

TO BE SUPPLIED TO:..... Gore District Council.....  
 (Building Consent Authority)

IN RESPECT OF: foundations comprising strip footings, floor slab, precast walls and suspended roof slab, concrete masonry bund walls, structural steel portal frames and associated bracing for new water treatment plant building..  
 (Description of Building Work)

AT: Wentworth St, East Gore

..... LOT..... DP SO ...  
 (Address)

We have been engaged by the owner/~~developer~~ referred to above to provide structural design and overview of construction sufficient to provide a PS4 on completion. services in respect of the requirements of

Clause(s) ...B1/VM1,VM4, of the Building Code for  
 All  or Part only X (as specified in the attachment to this statement), of the proposed building work.

The design carried out by us has been prepared in accordance with:

X Compliance Documents issued by the Ministry of Business, Innovation & Employment B1/VM1,VM4, NZS 1170,3101, 3404,4230.or

(verification method / ~~acceptable solution~~)

Alternative solution as per the attached schedule.....

The proposed building work covered by this producer statement is described on the drawings titled Gore Water Treatment Plant Upgrade

New Building Details and numbered 20080 / S01-S13 ; together with the specification, and other documents set out in the schedule attached to this statement.

On behalf of the Design Firm, and subject to:

- (i) Site verification of the following design assumptions Foundation bearing based on 50KPa allowable bearing
- (ii) All proprietary products meeting their performance specification requirements;

I believe on reasonable grounds that a) the building, if constructed in accordance with the drawings, specifications, and other documents provided or listed in the attached schedule, will comply with the relevant provisions of the Building Code and that b), the persons who have undertaken the design have the necessary competency to do so. I also recommend the following level of construction monitoring/observation:

CM1 X CM2 CM3  CM4  CM5 (Engineering Categories) Or as per agreement with owner/developer (Architectural)

I, ...Darryl Kensington..... am:  
 (Name of Design Professional)

x CPEng ..87325.....#

Reg Arch ..... #

I am a Member of: X IPENZ  NZIA and hold the following qualifications:BE,CMEngNZ,CPEng(civil,struct'I)IntPE(NZ)  
 The Design Firm issuing this statement holds a current policy of Professional Indemnity Insurance no less than \$200,000\*.

The Design Firm is a member of ACENZ:

SIGNED BY .....D Kensington..... ON BEHALF OF ..... KENSINGTON CONSULTING LTD...  
 (Design Firm)

Date..... 4/12/20 ..... (signature).....

Note: This statement shall only be relied upon by the Building Consent Authority named above. Liability under this statement accrues to the Design Firm only. The total maximum amount of damages payable arising from this statement and all other statements provided to the Building

## GUIDANCE ON USE OF PRODUCER STATEMENTS

Producer statements were first introduced with the Building Act 1991. The producer statements were developed by a combined task committee consisting of members of the New Zealand Institute of Architects, Institution of Professional Engineers New Zealand, Association of Consulting Engineers New Zealand in consultation with the Building Officials Institute of New Zealand. The original suit of producer statements has been revised at the date of this form as a result of enactment of the Building Act (2004) by these organisations to ensure standard use within the industry.

The producer statement system is intended to provide Building Consent Authorities (BCAs) with reasonable grounds for the issue of a Building Consent or a Code Compliance Certificate, without having to duplicate design or construction checking undertaken by others.

**PS1 Design** Intended for use by a suitably qualified independent design professional in circumstances where the BCA accepts a producer statement for establishing reasonable grounds to issue a Building Consent;

**PS2 Design Review** Intended for use by a suitably qualified independent design professional where the BCA accepts an independent design professional's review as the basis for establishing reasonable grounds to issue a Building Consent;

**PS3 Construction** Forms commonly used as a certificate of completion of building work are Schedule 6 of NZS 3910:2013 or Schedules E1/E2 of NZIA's SCC 2011<sup>2</sup>

**PS4 Construction Review** Intended for use by a suitably qualified independent design professional who undertakes construction monitoring of the building works where the BCA requests a producer statement prior to issuing a Code Compliance Certificate.

This must be accompanied by a statement of completion of building work (Schedule 6).

The following guidelines are provided by ACENZ, IPENZ and NZIA to interpret the Producer Statement.

### Competence of Design Professional

This statement is made by a Design Firm that has undertaken a contract of services for the services named, and is signed by a person authorised by that firm to verify the processes within the firm and competence of its designers.

A competent design professional will have a professional qualification and proven current competence through registration on a national competence based register, either as a Chartered Professional Engineer (CPEng) or a Registered Architect.

Membership of a professional body, such as the Institution of Professional Engineers New Zealand (IPENZ) or the New Zealand Institute of Architects (NZIA), provides additional assurance of the designer's standing within the profession. If the design firm is a member of the Association of Consulting Engineers New Zealand (ACENZ), this provides additional assurance about the standing of the firm.

Persons or firms meeting these criteria satisfy the term "suitably qualified independent design professional".

### \*Professional Indemnity Insurance

As part of membership requirements, ACENZ requires all member firms to hold Professional Indemnity Insurance to a minimum level.

The PI Insurance minimum stated on the front of this form reflects standard, small projects. If the parties deem this inappropriate for large projects the minimum may be up to \$500,000.

### Professional Services during Construction Phase

There are several levels of service which a Design Firm may provide during the construction phase of a project (CM1-CM5 for Engineers<sup>3</sup>). The Building Consent Authority is encouraged to require that the service to be provided by the Design Firm is appropriate for the project concerned.

### Requirement to provide Producer Statement PS4

Building Consent Authorities should ensure that the applicant is aware of any requirement for producer statements for the construction phase of building work at the time the building consent is issued as no design professional should be expected to provide a producer statement unless such a requirement forms part of the Design firm's engagement.

### Attached Particulars

Attached particulars referred to in this producer statement refer to supplementary information appended to the producer statement.

### Refer Also:

- 1 Conditions of Contract for Building & Civil Engineering Construction NZS 3910: 2013
- 2 NZIA Standard Conditions of Contract SCC 2011
- 3 Guideline on the Briefing & Engagement for Consulting Engineering Services (ACENZ/IPENZ 2004)
- 4 PN Guidelines on Producer Statements

[www.acenz.org.nz](http://www.acenz.org.nz)  
[www.ipenz.org.nz](http://www.ipenz.org.nz)  
[www.nzia.co.nz](http://www.nzia.co.nz)



# STRUCTURAL SPECIFICATION

of work to be done and materials to be used in carrying  
out the works shown on the accompanying drawings

Gore District Council

Water Treatment Plant  
Building

Job number: 20080

Date: November 2020

SPECIFICATION

FOR

EARTHWORKS

**CONTENTS**

	<u>PAGE NO.</u>
<b>1. SCOPE</b>	<b>3</b>
<b>2. STANDARDS</b>	<b>3</b>
<b>3. CONSENT</b>	<b>3</b>
<b>4. DISPOSAL OF MATERIALS</b>	<b>3</b>
<b>5. EXCAVATION OF TOPSOIL</b>	<b>4</b>
<b>6. EXCAVATION OF GROUND</b>	<b>4</b>
6.1 Services	4
6.2 Subgrade Profile	4
<b>7. SURFACE DRAINAGE CONTROL</b>	<b>5</b>
<b>8. SUBGRADE PREPARATION</b>	<b>5</b>
<b>9. BACKFILLING AND GEOTEXTILES</b>	<b>5</b>
9.1 Materials	5
9.1.1 Hardfill	6
9.1.2 Geotextiles	6
9.2 Placing And Compaction	6
<b>10. INSPECTION AND TESTING</b>	<b>7</b>

1. SCOPE

This Specification defines the requirements for quality of materials and workmanship for excavation and backfilling associated with subgrade preparation for concrete structures and underground site services. These earthworks comprise:

- (i) Excavation of topsoils.
- (ii) Excavation of ground to achieve required subgrade levels.
- (iii) Preparation of subgrade after excavation is complete.
- (iv) Backfilling, compaction and testing of fill materials.

The scope of work shall be as shown on the drawings 20080/S01-S13 other related drawings and this specification.

2. STANDARDS

All earthworks shall be carried out in accordance with all Statutory regulations. Excavating, loading, carting and disposal of spoil from the site shall be carried out in accordance with the relevant territorial authority bylaws and the appropriate Department of Labour acts and guidelines.

The latest amendment of NZS 4402 Methods of Testing Soils for Engineering purposes shall apply to this specification.

3. CONSENT

Before any work commences, the Contractor shall obtain all site **Clearance Certificate, Excavation Permit** and any other permits prior to undertaking any excavation or backfilling on site. All existing site services within the construction area shall be fully outlined or discovered before work commences. The Contractor shall submit details of his intended methods for excavation, shoring and dewatering (where required).

4. DISPOSAL OF MATERIALS

All excavated materials for disposal shall be stockpiled in areas as instructed by the Project Manager or disposed of offsite, if instructed otherwise.

**5. EXCAVATION OF TOPSOIL**

All rubbish, vegetation, topsoil, humus, and organic matter shall be excavated from the ground surface within the area limits of the earthworks.

Clean topsoil shall be stockpiled in the area designated on the drawings. The stockpiles shall be formed with sloping smooth surfaces.

**6. EXCAVATION OF GROUND**

**6.1 Services**

The Contractor shall take whatever precautions are necessary to avoid damaging or interfering with subsurface services that have been identified from the procedures outlined on the Clearance Certificate and Excavation Permit.

If the Contractor encounters subsurface services that have not been identified previously, he shall stop work and shall inform the Company Representative immediately. No further work shall be undertaken within that area until approved in writing.

**6.2 Subgrade Profile**

The Contractor shall excavate to the levels shown for all foundations, footings, ducts, trenches, pads, etc. cutting to the minimum sizes practicable. Sufficient room shall be allowed for form work and timbering outside the net sizes shown on the Drawings.

The subgrade surface so formed shall generally be graded with minimum falls to avoid ponding during construction. Excavation may be extended as required to permit adequate construction access.

The Contractor shall comply in all respects with the Construction Act, Construction Regulations, and the Work Safe Code of Practice for Excavations current at the time of performing the work. When works are notifiable, a copy of the submitted official notification shall be provided to the Project Manager.

Care shall be taken where excavating against or adjacent to existing structures, not to undermine foundations or damage services which are to remain.

On completion the subgrade surface shall be graded to ensure that the required excavation profile and batters are cut into sound foundation material without track marks from earthmoving equipment or other irregularities.

Care shall be taken to ensure that the excavation is carried out only in suitable weather conditions.

Where seepage is encountered, drainage blankets and subsoil drains shall be installed as directed to collect the seepage and discharge it to an approved point clear of the excavation.

Secure and maintain all excavations and stockpiles free from slippage, erosion and other foreign materials. Shoring, strutting, sheeting, pumps and other materials and plant necessary for carrying out and maintaining the excavations shall be provided and maintained by the Contractor until no longer required.

Prior to any backfilling, all excavations shall be proof rolled by the Contractor and inspected by the Engineer. The Contractor shall remove uneven or soft pockets of foundation material all as required by the Engineer. The Contractor shall advise the Engineer if any loose or soft ground is encountered during excavation and shall carry out remedial work as directed.

## **7. SURFACE DRAINAGE CONTROL**

The Contractor shall ensure that the Site is kept well drained and free from surface water. Any remedial work required as a consequence of the Contractor's failure to keep the site drained shall be repaired at the Contractor's expense. The Contractor shall comply with the Regional Council's requirements for the control of stormwater runoff.

## **8. SUBGRADE PREPARATION**

On completion of excavation, the exposed subgrade surfaces shall be proof compacted using a minimum of three passes of a heavy 10 T wheeled drum compactor. Any soft spots shall be removed and the areas backfilled in accordance with Clause 9 of this specification.

## **9. BACKFILLING AND GEOTEXTILES**

### **9.1 Materials**

All materials shall be supplied by the Contractor and shall conform to the requirements of this Specification and be approved by the Engineer prior to use in the work. The Contractor shall provide a complete written statement regarding the origin, composition, and manufacture of the material to be supplied by him.

The Contractor shall not change the source of supply of materials without written authorisation of the Engineer.

Backfill

The types of hardfill shall generally be defined on the contract drawings. The backfill types shall be:

Crushed Basecourse Dunite NZTA Specification M4, AP40 & AP65

This material shall be compacted to achieve at least 95% of the maximum dry density of the material as determined by Test 4.3.1 of NZS 4402 - Determination of the dry density/water content relationship, NZ vibrating hammer compaction test.

Geotextiles

Geotextile filter fabric and Geogrid mesh shall be as detailed on the drawings and as noted below in 9.1.2 Geotextiles. These geotextiles shall not be placed until the exposed subgrade has been proof rolled and approved to place by the Engineer.

9.1.1 Hardfill

Hardfill shall be well graded and conform to the following requirements:

Maximum Particle Size	40mm/65mm
Test Sieve Aperture	Percentage Passing by Weight
19mm	60-75
9.5mm	37-58
2.36mm	14-34
600 $\mu$ m	5-20
75 $\mu$ m	9 max

9.1.2 Geotextiles

Where specified the filter fabric shall comprise Bidim A29 grade non-woven, needle punched polyester fabric with minimum 450mm side lap and 1m end of roll lap. The Geogrid mesh shall comprise of Tensar TX 160 multidirectional grid mesh. Side laps shall be a minimum of 300mm and 1m end of roll.

**9.2 Placing and Compaction**

The Contractor shall spread the backfill material in layers appropriate to the type of compaction plant he intends to use. Fill layers shall not exceed 150 mm loose depth prior to compaction. These fill materials shall be compacted to the minimum dry densities specified. Results of all compaction tests shall be forwarded to the Engineer within 24 hours of the completion of the test.

The Contractor shall be responsible for ensuring that the compaction control is monitored to ensure that the required level of compaction is achieved evenly in all fill materials. Heavy compaction plant shall not be used within 0.5 m of the edge of existing buildings or structures. Light compaction plant shall be used within this zone to achieve the required level of compaction. Where light compaction plant is used, the maximum loose depth of the backfill shall be limited to 150 mm in each layer. No backfilling shall be undertaken until the relevant area has been inspected and approved. The Engineer shall reserve the right to conduct independent tests on compaction control during the course of the Contract.

Where the construction of any foundations requires the excavation of previously compacted backfill material, the backfill material shall subsequently be replaced and compacted in layers in accordance with the requirements above.

Backfilling shall not be carried out if rain or surface water make conditions unsuitable.

Prior to setting up boxing or concreting, all completed earthworks shall be inspected and approved.

Foundation backfilling shall not be commenced until stripped foundations have been inspected and approved.

**10. INSPECTION AND TESTING**

The Contractor shall arrange for and undertake all material and compaction testing. All results conforming and non-conforming are to be forwarded to the Engineer.

The minimum conforming testing frequency and required tests are:

<p><b>Hardfill</b></p> <p>Grading, crushing resistance, weathering resistance, and soil optimum dry density (Test 4.1.3, NZS 4402)</p> <p>Nuclear densometer test</p>	<ul style="list-style-type: none"> <li>- Two tests prior to commencement then 1 per &lt; 400m<sup>3</sup> 2 per 400 - 1500m<sup>3</sup> 3 per 1500 - 3000m<sup>3</sup></li> <li>- One test per 50m<sup>2</sup> per layer of compacted material</li> </ul>

Tests shall comply with:

- Grading - NZS 4402, Test 2.8
- Crushing Resistance - NZS 3111
- Weathering Resistance - NZS 3111

- Optimum Dry Density - NZS 4402, Test 4.1.3
- Insitu Density - NZS 4402, Test 5.1
- Nuclear Densometer Test - Backscatter mode

All testing shall be conducted at a Telarc registered or ISO 9000 accredited laboratory. The nuclear densometer shall be calibrated at a Telarc registered laboratory and operated by, or under the supervision of, an operator licensed by the NZ Nuclear Radiation Laboratory.

The Contractor shall facilitate inspection by the Engineer at all times during construction. The Company Representative may from time to time carry out check tests of soil properties, and relative compaction being achieved in the fill, but the Contractor shall remain responsible for achieving the required standard of work.

At any stage of the work, the Engineer may require material which has not been compacted to the specified standard or which contains unsuitable material, to be uncovered, excavated and replaced or recompacted to the specification without additional payment to the Contractor.

## Section 2                      CONCRETE

### 1.                      GENERAL

#### 1.1                    DOCUMENTS

Documents referred to in this section are:

NZS 3104	Specification for concrete production
NZS 3109	Concrete construction
NZS 3114	Specification for concrete surface finishes
NZS 3124	Concrete construction for minor works
NZS 3604	Timber framed buildings
AS/NZS 4671	Steel reinforcing materials

The documents also include the drawings titled Gore Water Treatment Plant upgrade- New Building and numbered 20080/ S01 – S13 other related drawings and this specification.

### 2.                      PRODUCTS

#### 2.1                    READY-MIX CONCRETE

Ordinary grade 25 MPa, maximum aggregate size 19 mm to NZS 3104 ground floor and foundations. Reinforced areas of the floor slab concrete shall have a minimum of 1 kg/m<sup>3</sup> of polypropylene fibre added also. Delivery dockets listing mix and despatch details to be supplied.

#### 2.2                    SITE CONCRETE

To NZS 3124. Shall be a minimum 10 MPa, all materials and batching to NZS 3104.

#### 2.3                    REINFORCEMENT

Bars to AS/NZS 4671. Grade 300 and Grade 500 deformed, other than for ties, stirrups and spirals, unless shown otherwise on the drawings. Welded reinforcing mesh to be ductile type complying with AS/NZS 4671.

#### 2.4                    TYING WIRE

Mild drawn galvanised steel or stainless steel wire not less than 1.2 mm diameter.

#### 2.5                    SPACERS AND CHAIRS

Precast concrete or purpose made moulded PVC to approval. Use concrete spacer blocks only where the concrete surface is not exposed in the finished work.

#### 2.6                    DAMPPROOF MEMBRANE

0.25 mm minimum polyethylene to NZS 3604, section 7.5.4.

### 3.                      EXECUTION

#### 3.1                    HANDLE AND STORE

Handle and store reinforcing steel and accessories without damage or contamination. Store on timber fillets on hard ground in a secure area clear of any building operation. Lay steel fabric flat.

Ensure reinforcement is clean and remains clean so that at the time of placing concrete it is free of all loose mill scale, loose rust and any other contamination that may reduce bonding capacity.

#### 3.2                    FALSEWORK AND FORMWORK

Use falsework and formwork of sufficient strength to retain and support the wet concrete to the required profiles and tolerances. Select formwork finish to produce the specified

finished quality. Ensure timber or plywood used for formwork is non-staining to the set concrete.

Securely fix and brace formwork sufficiently to support loads and with joints and linings tight enough to prevent water loss. Do not use tie wires or rods unless approved in writing by the owner. Unless detailed otherwise, provide a 19 mm chamfer or fillet strip at all interior and exterior angles of beam and column forms. Mitre at intersections.

Water blast to clean formwork. Keep formwork wet before concrete is placed.

Unless detailed otherwise, set up soffit boxing for beams and slabs to provide a camber when forms are stripped, of 3 mm rise for every 3 metres of total clear span.

- 3.3 **INSTALL DAMPPROOF MEMBRANE**  
Apply polythene membrane to prepared basecourse with 150 mm laps between sheets. Tape seal laps and penetrations with 50 mm wide pressure sensitive plastic tape. Refer to drawings for perimeter details.
- 3.4 **CUT AND BEND REINFORCEMENT**  
Cut and bend bars using proper bending tools to avoid notching and to the requirements of NZS 3109. Do not rebend bars without written approval.
- 3.5 **SECURE REINFORCEMENT**  
Secure reinforcement adequately with tying wire and place, support and secure against displacement when concreting. Bend tying wire back well clear of the formwork. Spacing as dimensioned, or if not shown, to the clear distance minimums laid down in NZS 3109, clause 3.6.
- 3.6 **LAPPED SPLICES**  
Set length of laps, where not dimensioned on the drawings, in accordance with NZS 3109, clause 3.7. Increase laps of plain round steel by 100%.
- 3.7 **REINFORCEMENT COVER**  
Minimum cover to all reinforcing bars, stirrups, ties and spirals, as shown on the drawings and to NZS 3109, clause 3.8. Fix chairs for top reinforcement in slabs at 1.0 metre centres or to ensure adequate support. Cover tolerances to NZS 3109, clause 3.9.
- 3.8 **CASTING IN**  
Build in all bolts and fixings for wall plates and bracing elements, holding down bolts, pipes, sleeves and fixings as required by all trades and as shown on the drawings, prior to pouring the concrete.
- Location and form of conduits to be approved in writing by the owner. Minimum cover 40 mm. Do not encase aluminium items in concrete. Do not paint steel embedded items more than 25 mm into the concrete encasement. Cut back form ties to specified cover and fill the cavities with mortar.
- Form all pockets, chases and flashing grooves as required by all trades and as shown on the drawings.
- Wrap all pipes embedded in concrete with tape to break the bond and to allow for expansion. Do not embed pipes for conveying liquids exceeding a temperature of 50°C in concrete.
- 3.9 **CONSTRUCTION JOINTS**  
Locate and construct as shown on the drawings.
- 3.10 **PRE-PLACEMENT INSPECTION**  
Do not place concrete until all excavations, boxing and reinforcing have been inspected and passed by the territorial authority inspector.
- 3.11 **SURFACE FINISHES**  
To NZS 3114, section 105, as scheduled or as denoted on the drawings.

- 3.12      **EXPOSED CONCRETE**  
 Formwork linings and surface finishes as nominated for both fair face and concealed or exposed surfaces. Unless detailed, obtain written confirmation of the type and pattern of all joints.
- 3.13      **CONCRETE SURFACE TOLERANCES**  
 To NZS 3114, sections 104 and 105, with the suggested tolerances becoming the required tolerances.
- 3.14      **PUMPING CONCRETE**  
 Set up and supervise pump operation, placing and compaction of the mix to NZS 3109. Advise the ready-mix supplier of the type of pump and the slump required, in addition to the concrete grade, strength and quantity.
- 3.15      **COMPACTION**  
 Use power operated vibrators on foundations, vertical constructions and beams.
- 3.16      **FLOOR SLAB**  
 Construct in accordance with NZS 3604, section 7.5. Lay to true and straight surfaces, screeded, floated and steel (manual or power) trowelled finish. Tolerance on flatness: maximum 3 mm gradual deviation over a 3 metre straight-edge, to the requirements of NZS 3109.
- 3.17      **SAW CUTS**  
 Cut slabs where indicated on the drawings and as required to control shrinkage cracking. Carry out cutting as soon as possible, without causing tear-out of aggregate and before shrinkage cracking has occurred, generally within 24 hours of pouring. Where saw cuts are made, cut out 100 mm of every second wire of the mesh for a length of 50 mm each side of the saw cut position. Saw cuts: 1/3rd slab depth or 30 mm minimum.
- 3.18      **SURFACE DEFECTS**  
 Make good surface defects immediately after forms are stripped. Make good hollows or bony areas with 1:2 mortar or plaster, finished to the same tolerances as the parent concrete. Fill any tie rod holes with 1:2 mortar.
- 3.19      **CURING OF CONCRETE**  
 Keep damp for not less than seven days. Ensure curing of slabs commences as soon as possible after final finishing, by the use of continuous water sprays, or ponding. Alternately, apply a curing membrane. Ensure any membrane used will not affect subsequent applied finishes.
- 3.20      **STRIKE FORMWORK**  
 Strike formwork without damaging or overloading structure. Do not remove formwork before the following minimum periods:
- |  |          |
|--|----------|
| Sides of beams, walls and columns:   | 12 hours |
| Slabs in beam and slab construction:<br>(leave props under slab spans over 2 metres) | 4 days   |
| Props from under slab spans over 2 metres:   | 10 days  |
| Beams, soffits and slab spans over 5 metres:   | 18 days  |
- 3.21      **CLEAN OUT**  
 Clean out saw cuts. Fill with cement grout where the floor will be covered with carpet or vinyl.
- 3.22      **REMOVE**  
 Remove all unused materials and all concrete and reinforcing debris from the site.

## Section 3                      PRECAST CONCRETE

### 1.                      GENERAL

This specification section shall be read in conjunction with the General and Specific Conditions.

#### 1.1                    SCOPE OF WORK

This section covers the manufacture, supply and installation of all precast reinforced concrete wall panel and flat slab roof elements.

#### 1.2                    DOCUMENTS REFERRED TO

Documents referred to in this section are:

NZS 3101	Concrete structures standard Part 1 The design of concrete structures
NZS 3104	Specification for concrete production
NZS 3109	Concrete construction
NZS 3114	Specification for concrete surface finishes
AS/NZS 4671	Steel reinforcing materials

Structural series drawings titled Gore Water Treatment Plant Upgrade- New Building and numbered 20080/S01-S13, other related drawings and this specification.

#### 1.3                    PRODUCER STATEMENT PS3- CONSTRUCTION

Provide a producer statement from a suitably qualified person covering the supply and installation of precast items.

#### 1.4                    QUALIFICATION, OFF-SITE WORK

Use only precast concrete workers skilled and experienced in form making, casting, transportation and erection of precast items.

#### 1.5                    SITE LOADINGS, PERMANENT STRUCTURE

Prevent damage to supporting structure from stacking of precast items.

#### 1.6                    ROOF SLAB DESIGN LOADINGS

The 100mm prestressed flat slab roof units shall be designed for the following:  
 Own self weight and 100mm topping concrete  
 Superimposed live load of 3 KPa  
 Appropriate design factors and combination of loading shall be applied to these loads.

#### 1.7                    SHOP DRAWINGS

Provide a set of shop drawings for review and approval prior to manufacture. Drawings to clearly indicate all lifting eye locations, type used and ratings. **Note: All lifting eyes to have at least twice the load rating over that actually required and shall be a proprietary type industry standard.**

### 2.                      PRODUCTS

#### 2.1                    CERTIFIED READY MIXED CONCRETE

Ordinary grade 40 MPa for precast elements, maximum aggregate size 19 mm to NZS 3104. Provide delivery dockets listing mix, additives, slump and dispatch details. All concrete for panels to have Aquaron 3000 waterproofing additive dosed as per manufacturers specifications.

#### 2.2                    REINFORCEMENT

Bars to AS/NZS 4671. Grade 300E and Grade 500E deformed, proprietary REIDBAR other than for ties, stirrups and spirals, unless shown otherwise on the drawings. Welded reinforcing mesh to AS/NZS 4671.

- 2.3 **TYING WIRE**  
Mild drawn **galvanised** steel or stainless steel wire not less than 1.2 mm diameter.
- 2.4 **SPACERS AND CHAIRS**  
Use purpose made moulded PVC chairs to approval.
- 2.5 **CAST IN STEEL ITEMS**  
Hot dip galvanise after manufacture to a coating weight of 600 grams/m<sup>2</sup> all cast in weld plates.
- 2.6 **SEATINGS**  
Rigid plastic shims/levelling pads shall be used full length beneath all end seating of precast slab units.
- 2.7 **GROUTING OF PANEL TO PANEL SHEAR KEYS**  
The vertical edge joint keys shall be pressure grouted using a standard cement based general purpose grout of maximum strength 25MPA at 28 days
- 2.8 **GROUTING OF DROSBACH DUCT SLEEVES**  
All Drosbach ducts shall be pressure grouted from the base level duct with proprietary Sika 212 cementitious grout by specialist Contractors until the grout flows from the top duct uniform in texture and free of air bubbles. Gouting ducts shall be arranged on the interior panel face.
- 3. EXECUTION**
- Conditions**
- 3.1 **HANDLE, TRANSPORT AND STACK**  
Handle, transport and stack panels to ensure support that avoids distortion and stress and at the same time protects the finished surfaces from chipping, scoring, cracking or other disfigurement.
- 3.2 **TOLERANCES, OFF SITE PRECAST**  
Manufacture cladding panels to the following tolerances:
- |   |              |        |
|---|--------------|--------|
| Length and height:  | < 9.0 metres | ± 2 mm |
| Thickness overall:  |              | ± 3mm  |
| Deviation from square:<br>(difference in length between two diagonals)      | Length       | ± 3mm  |
| Twist:<br>(any one corner out of plane passing through other three corners) |              | ± 1 mm |
| Position of panel openings and cast in items:                               |              | ± 2mm  |
- 3.3 **SECURE REINFORCEMENT**  
Secure adequately with tying wire and place accurately where detailed, supported and secured against displacement.
- 3.4 **CONCRETE PLACING**  
Carefully place concrete in layers so that all parts of the mould are completely filled and full contact is made with the face to give a totally uniform finish. Use approved compaction techniques with power driven vibrators to give a uniform, void-free concrete panel.
- 3.5 **CASTING IN ITEMS**  
Accurately cast in all embedded items and fixings as detailed with full compactness all round. Inserts shall be rigidly held in location prior to casting. No "puddling-in" of inserts will be permitted.
- 3.6 **CURING**  
Confirm in writing the system to be used for curing concrete. Cure panels for a minimum of 7 days. Keep the time between casting and the start of curing to an absolute minimum.

Apply a fine spray of water continuously over the curing period through a system of nozzles placed to cover the whole of the panels being cured.

### 3.7 TOLERANCES, ON SITE EXECUTION

Locate precast items to the following tolerances:

Plan:  $\pm 3$  mm  
 Vertical:  $\pm 1$  mm per metre

### 3.8 SEALANTS

Ensure at time of erection, that the limits of acceptable joint variation (from the manufacturer's requirements) for each product are maintained. Prepare joints, protect adjoining surfaces, prime joint edges, seal joint surfaces, fit limiting rods and insert sealant to the manufacturer's requirements and temperature limits.

Standard joint sealant AT Façade or equal approved installed as per manufacturers specifications to the exterior face of wall joints and interior face where not specified to be a fire rated sealant.

Interior face wall joints to the Chlorine storage room shall be sealed with Sika Firerate PU installed as per the manufacturers specifications.

### 3.9 REID ANCHOR - EPOXY FILLING

All Reid bars anchored into the base fixing inserts of the panels shall be epoxied in place by using Ramset C6 epoxy applied into the socket immediately prior to installing and tightening the bar. Sufficient epoxy shall be installed to express around the socket circumference when bar is fully tightened. The sockets shall be free of all dirt and grease prior to placing the epoxy.

### 3.9 CLEAN AND DRESS

Clean and dress panels externally and internally to leave them to the standard of finish specified and without blemish, ensuring following work can be completed to the required standard.

### 3.10 CLEAN UP

Clean up surrounding areas of trade waste and remove temporary works required for the installation of the precast concrete items.

### 3.11 REMOVE

Remove debris, unused materials and elements from the site.

## 4. SCHEDULES

### 4.1 SURFACE FINISHES

Formed surfaces:	F4 finish to NZS 3114
Unformed surfaces:	U3 finish to NZS 3114

**Section 4****CONCRETE MASONRY****1. GENERAL****1.1 DOCUMENTS**

Documents referred to in this section are:

NZBC B1/AS1	Structure general, 2.0 Masonry
NZS 3103	Sands for mortars and plasters
NZS 3109	Concrete construction
NZS 3604	Timber framed buildings
NZS 4210	Masonry construction: materials and workmanship
NZS 4229	Concrete masonry buildings not requiring specific engineering design
AS/NZS 4455	Masonry units and segmented pavers
AS/NZS 4671	Steel reinforcing materials

The documents also include the drawings titled Gore Water Treatment Plant Upgrade-New Building and numbered 20080/ S01 – S13 other related drawings and this specification.

**1.2 MANUFACTURER'S DOCUMENTS**

Manufacturer's and supplier's documents relating to work in this section are:

~ Firth open ended reinforcing concrete masonry blocks

**1.3 QUALIFICATIONS**

Carry out all masonry work with people competent and experienced in this type of work, under the supervision of a registered mason. The registered mason to certify in writing to the owner that the observation has been carried out in accordance with the relevant New Zealand Standards.

**1.4 INSPECTION**

Call for inspection of the work at critical stages including set out, reinforcing, and the time prior to and during grouting. All to recognised trade practice as set out in NZS 4210, clause 1.4.

**1.5 TESTS**

Carry out all required tests in accordance with NZS 4210, appendix 2A.

**1.6 QUALITY RECORDS**

Keep accurate records relating to strength and quality of materials used in the construction, and make the information available to the territorial authority inspector on request.

**2. PRODUCTS****2.1 MASONRY UNITS**

To AS/NZS 4455.

**2.2 REINFORCEMENT**

To AS/NZS 4671 and as detailed.

**2.3 MORTAR**

Sand to NZS 3103. Chloride levels to not exceed 0.04% by dry weight of sand. Mortar to NZS 4210, section 2.2. Compressive strength of not less than 12.5 MPa.

**2.4 GROUT**

To NZS 4210, section 2.3. Spread value 450 – 530 mm.

**2.5 WATER**

Clean, fresh and free from excess alkali, salt, silt and organic materials. Water from a local authority water supply is acceptable.

### **3. EXECUTION**

- 3.1 **MASONRY CONSTRUCTION GENERALLY**  
To NZS 4210 and NZS 4229.
- 3.2 **STORAGE**  
Store masonry units clear of the ground, under cover and well ventilated until placed in the work.
- 3.3 **MOISTURE CONTENT**  
Ensure masonry units are air dry prior to laying.
- 3.4 **CHECK BASE CONCRETE**  
Ensure the base concrete is true to line and level, requiring a base mortar bed of 10 mm (minimum) to 20 mm (maximum). Ensure that all laitance, loose aggregate, or anything preventing bond is removed prior to laying masonry units.
- 3.5 **STARTER POSITIONS**  
Before commencing laying masonry units, check the location of starter reinforcement by measure or by a dry trial lay up of the first course. Do not correct misplacement by cranking bars. Where misplacement exceeds the location tolerance, obtain written direction before proceeding.
- 3.6 **REINFORCEMENT AND GROUTING**  
Reinforcement detailed, bent and placed in accordance with NZS 4210. Refer to drawings for details of reinforcement and extent of grout filling.
- 3.7 **COVER**  
Minimum cover as required for reinforced concrete, with grout and masonry treated as a homogeneous material. Maintain reinforcing bars for retaining walls a minimum of 15 mm and for other masonry a minimum of 6 mm from the masonry work face, with the space filled with grout.
- 3.8 **TOLERANCES**  
Construct within the tolerances set out in NZS 4210, clauses 2.6.5 and 2.7.1. Lay masonry units with bedding of consistent thickness throughout.
- 3.9 **PROTECTION**  
Protect fair-faced masonry walls, keeping them clear of mortar droppings, grout splashes, or stains of any kind.
- 3.10 **LAY MASONRY UNITS**  
Ensure consistent, fully filled and tooled joints. Where walls are reinforced, prevent mortar droppings from entering the cells to be grouted. Provide clean out holes at base of wall, unless "low lift" (NZS 4210) grouting is used. Ensure reinforcement is accurately placed and tied. Lay in regular running bond with all necessary special units and sill units. Cut masonry, if necessary, true and square without chipping.
- 3.11 **MASONRY UNITS JOINTS**  
Not exceeding 10 mm thick, or less than 8 mm when the units are bedded in. Joints tooled concave, unless detailed otherwise.
- 3.12 **CONTROL JOINTS**  
Locate at major changes of wall height or thickness, at openings, and at not more than 8 metre centres, or, as shown on the drawings. Where reinforcement passes through a control joint, provide for breaking bond using methods detailed on NZS 4210, figure 2.10.1, unless specifically detailed otherwise.



## Section 5                      STRUCTURAL STEELWORK

### 1.                      GENERAL

#### 1.1                    DOCUMENTS

Documents referred to in this section are:

NZBC	F5/AS1 Construction and demolition hazards
AS/NZS 1111	ISO metric hexagon commercial bolts and screws
AS/NZS 1252	High-strength steel bolts with associated nuts and washers for structural engineering
AS/NZS 1554	Structural steel welding, 1554.1 Welding of steel structures
AS/NZS 2312	Guide to the protection of iron and steel against atmospheric corrosion
NZS 3404	Steel structures Standard, Part 1: Steel structures Standard
AS 3828	Guidelines for the erection of building steelwork
AS/NZS 4680	Hot-dip galvanised (zinc) coatings on fabricated ferrous articles
AS/NZS 4792	Hot-dip galvanised (zinc) coatings on ferrous hollow sections
HERA	Report R4-99 "HERA specification for the fabrication, erection and surface treatment of structural steelwork".

The documents also include the drawings titled Gore Water Treatment Plant Upgrade-New Building and numbered 20080/ S01 –S13 other related drawings and this specification.

#### 1.2                    QUALIFICATIONS

Welders to be qualified and certificated in all the various welds required for the project. Documentary evidence from an approved reviewing authority that the particular personnel engaged on the work shall be provided. This shall state the individual and the types of weld they are qualified to undertake.

#### 1.3                    SHOP DRAWINGS

Supply 1 set of shop and erection drawings to the Engineer for review prior to fabrication.

#### 1.4                    SHOP DRAWINGS REVIEW

Shop drawings review indicates the design concept has been reviewed without the need for further modification. This does not relieve the contractor of any responsibility for the correctness of the shop drawings, site dimensions, or for ensuring the work is performed in compliance with the drawings and specifications.

#### 1.5                    VERIFY DETAILS AND DIMENSIONS

Refer to drawings to ensure all required details and fixings are provided for in the structural steelwork. Verify dimensions against site measurements prior to fabrication.

#### 1.6                    TEST WELDING

Non-destructive test welding with method, extent and standards of acceptance to AS/NZS 1554.1, appendix F, with the suggested extent becoming the required extent.

### 2.                      PRODUCTS

#### 2.1                    STRUCTURAL STEEL

All steel Grade 300, except RHS sections Grade 350, unless noted otherwise on the drawings. Test and stress relieve for brittle fracture when required by NZS 3404, part 1, section 17.

#### 2.2                    WELDING

Electrodes to comply with and be selected for the grade of steel being welded as required by AS/NZS 1554.1. Welding wire as required by the wire manufacturer for the materials to be joined and the welding position. Welding flux: dry and used from sealed containers. Material for arc stud welding to comply with AS/NZS 1554.1.

KENSINGTON CONSULTING

- 2.3 **BOLTS, NUTS AND WASHERS**  
To AS/NZS 1111 and AS/NZS 1252. Hot dip galvanise all bolts, nuts and washers forming a permanent part of any structure subject to a protective coating, to AS/NZS 4680.
- 3. EXECUTION**
- 3.1 **SURFACE FINISH**  
Grind off all burrs and sharp arrises.
- 3.2 **TOLERANCES**  
Discard material showing visual defects affecting its structural integrity. Structural elements to comply with NZS 3404, part 1, section 14.4 (straightness, full contact splices, length and struts not prepared for full contact). Comply with the required tolerances laid down for holding down bolts, columns, beams and other members in HERA Report R4-99, sections 2.5, 4.5 and 5.6.
- 3.3 **CUTTING**  
To NZS 3404, part 1, clause 14.3.3 and HERA Report R4-99, sections 1.5 and 4.6. Hand cut only where machine cutting is not possible.
- 3.4 **CONSTRUCT**  
Construct the steel structure as detailed and to NZS 3404, part 1, section 14 (fabrication) and part 1, section 15 (erection).
- 3.5 **WELDING**  
To NZS 3404, part 1, clause 14.3.4 and AS/NZS 1554.1. Comply with AS/NZS 1554.1 for guidance on welding inspection and quality control.
- 3.6 **HOLING**  
To NZS 3404, part 1, clause 14.3.5 for sizes, alignment, finishing and punching of holes.
- 3.7 **BOLTING**  
Bolting to comply with NZS 3404, clause 14.3.6.
- 3.8 **THREADS EXCLUDED FROM SHEAR PLANE**  
Select length of bolts such that the threaded portion does not occur within the shear plane between joined parts.
- 3.9 **START ERECTION**  
Start erection only when the holding down bolts and anchorages have achieved sufficient strength. Carry out the erection of the structural steel to the requirements of AS 3828. Comply with NZBC acceptable solution F5 and NZS 3404, part 1, section 15. Provide temporary bracing as required to achieve stability during erection.
- 3.10 **BASE PLATES**  
Enlargement or site cutting of holes not permitted. Bending or displacement of holding down bolts not permitted.
- 3.11 **COLUMNS**  
Plumb columns using sawn steel packs and wedges not larger than necessary for the purpose. The column base must not be raised by more than 25 mm. Fill space beneath the base plate with cement-sand grout, containing a non-shrink additive, the grout having a minimum compressive strength of 30MPa at 28 days. Alternately use a dry pack of 1:2 cement with the sand mortar hammered in tight to ensure complete filling of space.
- 3.12 **INSPECTION**  
Inspect all stages of fabrication and construction of the structure to NZS 3404, part 1, sections 14 (fabrication) and 15 (erection).

- 3.13      **ENCASED STEELWORK**  
Where required clean the steelwork to be encased in concrete to remove all loose mill scale, rust, dirt and other matter affecting bond with concrete. Achieve this by wire brushing and the use of suitable solvents.
- 3.14      **BRUSH CLEANING**  
Remove oil and grease by the use of solvents. Scrape and power wire brush to bright metal. Avoid producing a polished surface. Ensure no burrs or sharp arrises remain which may prevent full coating thickness being attained. Prime immediately and paint as soon as practicable.
- 3.15      **BLAST CLEANING**  
Remove oil and grease by the use of solvents. Abrasive blast clean to bright metal to SA 2.5. Select grit type and equipment such that the cleaned surface profile between peaks and valleys does not exceed one third of the dry film thickness. Ensure no burrs or sharp arrises remain which may prevent full coating thickness being attained. Prime immediately and paint as soon as practicable.
- 3.16      **PRIMING**  
After cleaning and grit blasting to bright metal in the workshop, unless noted otherwise coat all steelwork, with minimum 75um epoxy zinc coating. Patch prime on site after erection, using a compatible priming system.
- 3.17      **GALVANISING**  
Clean sections thoroughly and apply zinc coating to the requirements of AS/NZS 4680 and AS/NZS 4792 (hollow sections) to give a coating weight of not less than 600 grams per square metre.
- 3.18      **ZINC SPRAYING**  
To AS/NZS 2312 with clear seal finish  
- Abrasive blast clean to AS 1627.4, class 2<sup>1</sup>/<sub>2</sub>, minimum profile 10 microns  
- Apply spray coating before discoloration and within 4 hours  
- Steel temperature 3°C minimum above dew point and less than 150°C
- 3.19      **UNPAINTED SURFACES**  
Do not paint:  
- faying face of high strength friction grip bolted joints  
- areas for site welding, keeping 75 mm clear all round  
- surfaces being embedded in concrete.
- Where steel is only partly encased then extend priming 25 mm maximum into the concrete encasement area.
- 3.20      **PATCH PRIMING**  
Clean areas of damaged priming and areas left clear for site jointing to a standard comparable with that specified for shop cleaning. Wash off chemical deposits from welding fumes. Apply priming coats to the same standard as shop primers, ensuring thorough coating of bolts, nuts and connection areas. Reprime if more than 4 weeks elapse before the final coating system is applied.
- 3.21      **COATING SYSTEMS**  
Apply all coatings in accordance with the coating manufacturer's requirements. Apply coatings to steel within 4 hours of cleaning and before condensation or light rusting can occur. Ensure steel is dry and atmospheric conditions warm and dry, with an air temperature of greater than 12°C and relative humidity less than 85%.
- Touch-up/repair any damage to the coating system before linings are placed.
- Fully protect coating systems from damage during construction. Repair any damage strictly as per the manufacturer's specifications.

KENSINGTON CONSULTING

- 3.22 WELDING  
Shop weld together touching or near-touching steelwork all round with 5 mm (one pass) continuous fillet welds unless denoted otherwise on the drawings.

#### 4. SCHEDULES

- 4.1 COATING SYSTEM  
All steel work shall be prime coated in accordance with section 3.16 after blast cleaning in accordance with section 3.15.

- 4.1 WELD TESTING  
The following are the minimum requirements for testing of welds by an independent testing authority. Test locations and results for all members shall be documented including type of inspection, result and any remedial work undertaken and included as part of PS3 documentation.
- 100% visual
  - All Column base plates and all rafter/ apex connection plates to 360UB– mag particle

- 4.2 PRIMER  
Resene Armourzinc 120- 75u DFT or equal approved by Engineer.

- 4.3 PROTECTIVE COATINGS (to all exposed interior steel)  
1st coat Resene Armourcote 515/510 125u DFT or equal approved by Engineer.  
2<sup>nd</sup> coat Imperite I.F. 503 50u DFT or equal approved by Engineer.

## **Section 6 SPECIAL COATINGS – BUND AREA**

### **1.1 GENERAL**

#### **.1 SCOPE OF WORK**

This section deals with the manufacture, supply and installation of floor and wall coatings including covings, upstands, plinths and dressing to sumps in banded areas shown in the drawings titled Gore Water Treatment Plant Upgrade- New Building and numbered 20080/S01-S13.

#### **.2 Documents**

##### **MANUFACTURER'S DOCUMENTS**

Manufacturer's and supplier's documents relating to work in this section are available from:

Armatec Environmental Ltd

Web: [www.armatec.co.nz](http://www.armatec.co.nz)

Email: [info@armatec.co.nz](mailto:info@armatec.co.nz)

Telephone: 06 755 0410

Facsimile: 06 755 2346

Approved equivalent suitably experienced applicators will also be considered.

#### **.3. Requirements**

##### **SHOP DRAWINGS AND INSTALLATION DETAILS**

Provide drawn profiles and preliminary installation details for evaluation

Shop drawings to show, but not be limited to:

- Complete details of construction, connections (minimum scale 1:10)
- Sealant types
- Provision for thermal movement and bridging of joints
- Sequence of installation
- Co-ordination requirements with other work and full schedule of materials

##### **SHOP DRAWINGS REVIEW**

Shop drawing review indicates only that the supplied interpretation of the design concept has been reviewed without the need for further modification, other than the corrections indicated by the reviewer. It does not relieve the contractor of the responsibility for ensuring the correctness of shop drawings, site dimensions, the overall design, or for ensuring the work complies with the contract documents. Nor can it be construed as authorising departures from the contract documents.

##### **REVISED SHOP DRAWINGS**

Provide a copy of shop drawings revised to include required modifications, before proceeding with any fabrication or erection.

**.4 Guarantees**

**GUARANTEE**

Guarantee this work under specific environmental and use conditions against failure of materials, watertightness and execution:

Have a minimum expected life of 25 years before recoating including normal wear and tear including walking, placing ladders and similar activities expected in such an area.

**.5 Performance**

**PERFORMANCE OF FLOOR & WALL COATING**

Tenderers to confirm performance and compliance in accordance with the following requirements

Exposure, immersion and contact to chemicals as listed:

Hydrofluosilicic acid (17% w/w)

ACH (aluminium chloral hydrate 50% w/w)

PACl (polyaluminium chloride 34% w/w)

Caustic soda (25-50% w/w)

- Outdoor use.
- Pedestrian and other traffic will occur regularly
- A wet anti-slip surface is required with a minimum coefficient of 0.55
- Food hygiene performance
- Floors will fall to sumps at 1:50 maximum
- Include a bond breaker and reinforcement over wall/floor junctions and construction joints to enable movement to be accommodated.
- Miscellaneous plinths will require coating under equipment
- Quick curing rate
- High impact resistance
- Consistent colour match between batches
- Provide a water tight finish, noting blockwork is utilised for internal bund walls. Bunds will be water tested on completion and no detectable seepage through walls or significant water loss will be allowed

**1.2 PRODUCTS**

**.1 Materials**

Ceilcote Flakeline or approved equivalent, subject to compatibility with the application especially in regard to flexible sealants in joints.

**SUPERCEDED**

---

**SUPERCEDED**

# Pall Marshall Water Consortium

189 Bond Street  
 PO Box 846  
 Invercargill 9840  
 NEW ZEALAND  
 Telephone: +64 3 218 2579  
 Facsimile: +64 3 214 9168  
 tom@marshalls.co.nz

## DRAWING/DOCUMENT TRANSMITTAL FORM

04 December 2020

**SUPERCEDED**

<b>Client:</b>	Gore District Council	<b>Project:</b>	Gore WTP Upgrade
<b>Attention:</b>	Hashem Ramezan-Zadeh	<b>Contract Number:</b>	GDC 2019/01
<b>From:</b>	Donovan Harvey	<b>Transmittal Number:</b>	GOR 014

**Document Sent For:** Approval

<i>Drawing Number</i>	<i>Drawing Name</i>	<i>Revision</i>	<i>Drawn/Written By</i>
N/A	SPEC and Producer Statement – PS1	N/A	Kensington Consulting
20080-S01	Floor Plan and Panel Lauout	0	D. Kensington
20080-S02	Structural Steel Plan	0	D. Kensington
20080-S03	Building Sections	0	D. Kensington
20080-S04	Building Sections and Details	0	D. Kensington
20080-S05	Building Sections and Details	0	D. Kensington
20080-S06	Precast Panels North & South Elevations	0	D. Kensington
20080-S07A	East Wall Precast Panels Details	0	D. Kensington
20080-S07B	East Wall Precast Panels Details	0	D. Kensington
20080-S08	West Wall Precast Panels Details	0	D. Kensington
20080-S09	South Wall Precast Panels	0	D. Kensington
20080-S10	North Wall Precast Panels	0	D. Kensington
20080-S11	North Wall Precast Panels	0	D. Kensington
20080-S12	Internal Precast Panel Details	0	D. Kensington
20080-S13	Chlorine Room Ceiling	0	D. Kensington

Regards,

**SUPERCEDED**


Donovan Harvey  
 Project Manager



RECEIVED  
 Gore District Council

20 JAN 2021  
 1:28 PM

**SUPERCEDED**

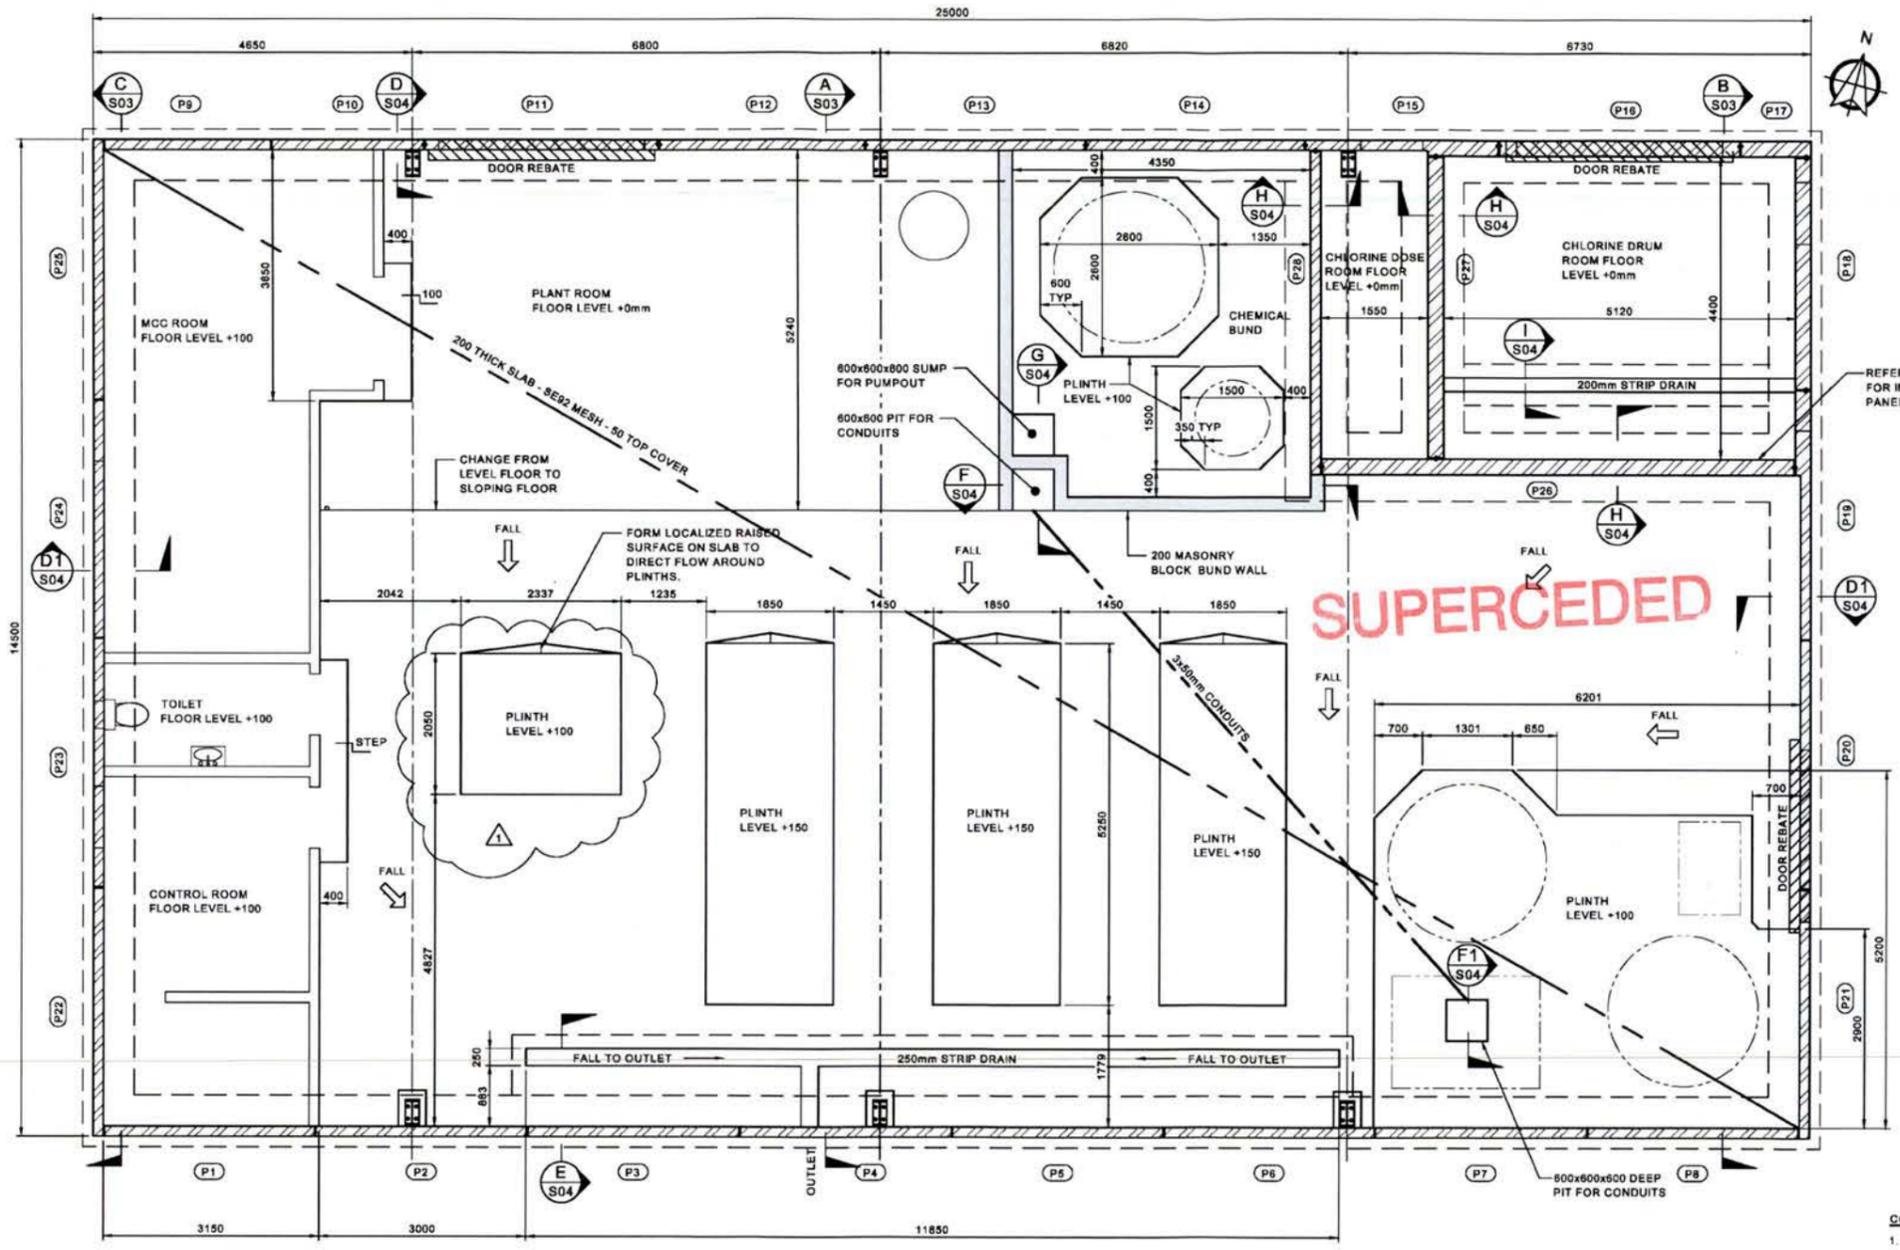

**FLOOR PLAN**  
 1:50 at A1  
 1:100 at A3

**CONCRETE NOTES**

1. CONCRETE STRENGTH SHALL BE 25 MPa AT 28 DAYS FOR FOUNDATIONS / FLOOR CONCRETE AND MASONRY BLOCK GROUT. THE FLOORSLAB SHALL ALSO CONTAIN MIN 1kg POLYPROPYLENE FIBRE.
2. CONCRETE STRENGTH SHALL BE 40 MPa AT 28 DAYS FOR PRECAST PANELS.
3. ALL STRUCTURAL CONCRETE SHALL BE CERTIFIED "SPECIAL GRADE"
4. REINFORCING LAP LENGTHS: HD10 - 700 mm, HD12 - 850 mm, HD18 - 1,050 mm, MESH - 200 mm
5. ALL REINFORCING STEEL SHALL HAVE 75mm MINIMUM COVER IN FOUNDATIONS, UNLESS NOTED OTHERWISE.
6. BAR DESIGNATION: HD = GRADE 500E DEFORMED BARS; D = GRADE 300E DEFORMED BARS; R = GRADE 300E ROUND BARS; RB = GRADE 500 (REID BAR) DEFORMED BARS.
7. BASE PLATE GROUTING - USE SIKA GROUT 212 OR APPROVED EQUIVALENT.
8. STARTER BAR GROUTING - USE RAMSET EPCON C6 OR APPROVED EQUIVALENT.
9. ALL ANCHOR STUDS SHALL BE GALVANISED GRADE 8.8, MIN EMBEDMENT OF 150mm, UNLESS STAINLESS STEEL SPECIFIED OTHERWISE.

**SUPERCEDED**

Rev No	REVISION DESCRIPTION	DRAWN	APPROVED	DATE
1	PLINTH RELOCATED	ITB	DK	4:12:20
0	ISSUED FOR CONSENT / CONSTRUCTION	ITB	DK	1:12:20

	BY	DATE
DESIGNED	DK	10:20
DESIGN CHECK	DK	11:20
DRAWN	ITB	10:20
APPROVED		

**KENSINGTON CONSULTING**  
 Civil and Structural Engineers  
 03 218 7936 027 403 3773


**GORE WATER TREATMENT PLANT  
 UPGRADE - NEW BUILDING  
 FLOOR PLAN AND PANEL LAYOUT**

STATUS		
CONSENT / CONSTRUCTION		
SCALE AT A1		
PROJECT NUMBER	DRAWING NUMBER	REV.
20080	S01	1

RECEIVED  
 Gore District Council

20 JAN 2021  
 1:28 PM

**SUPERCEDED**

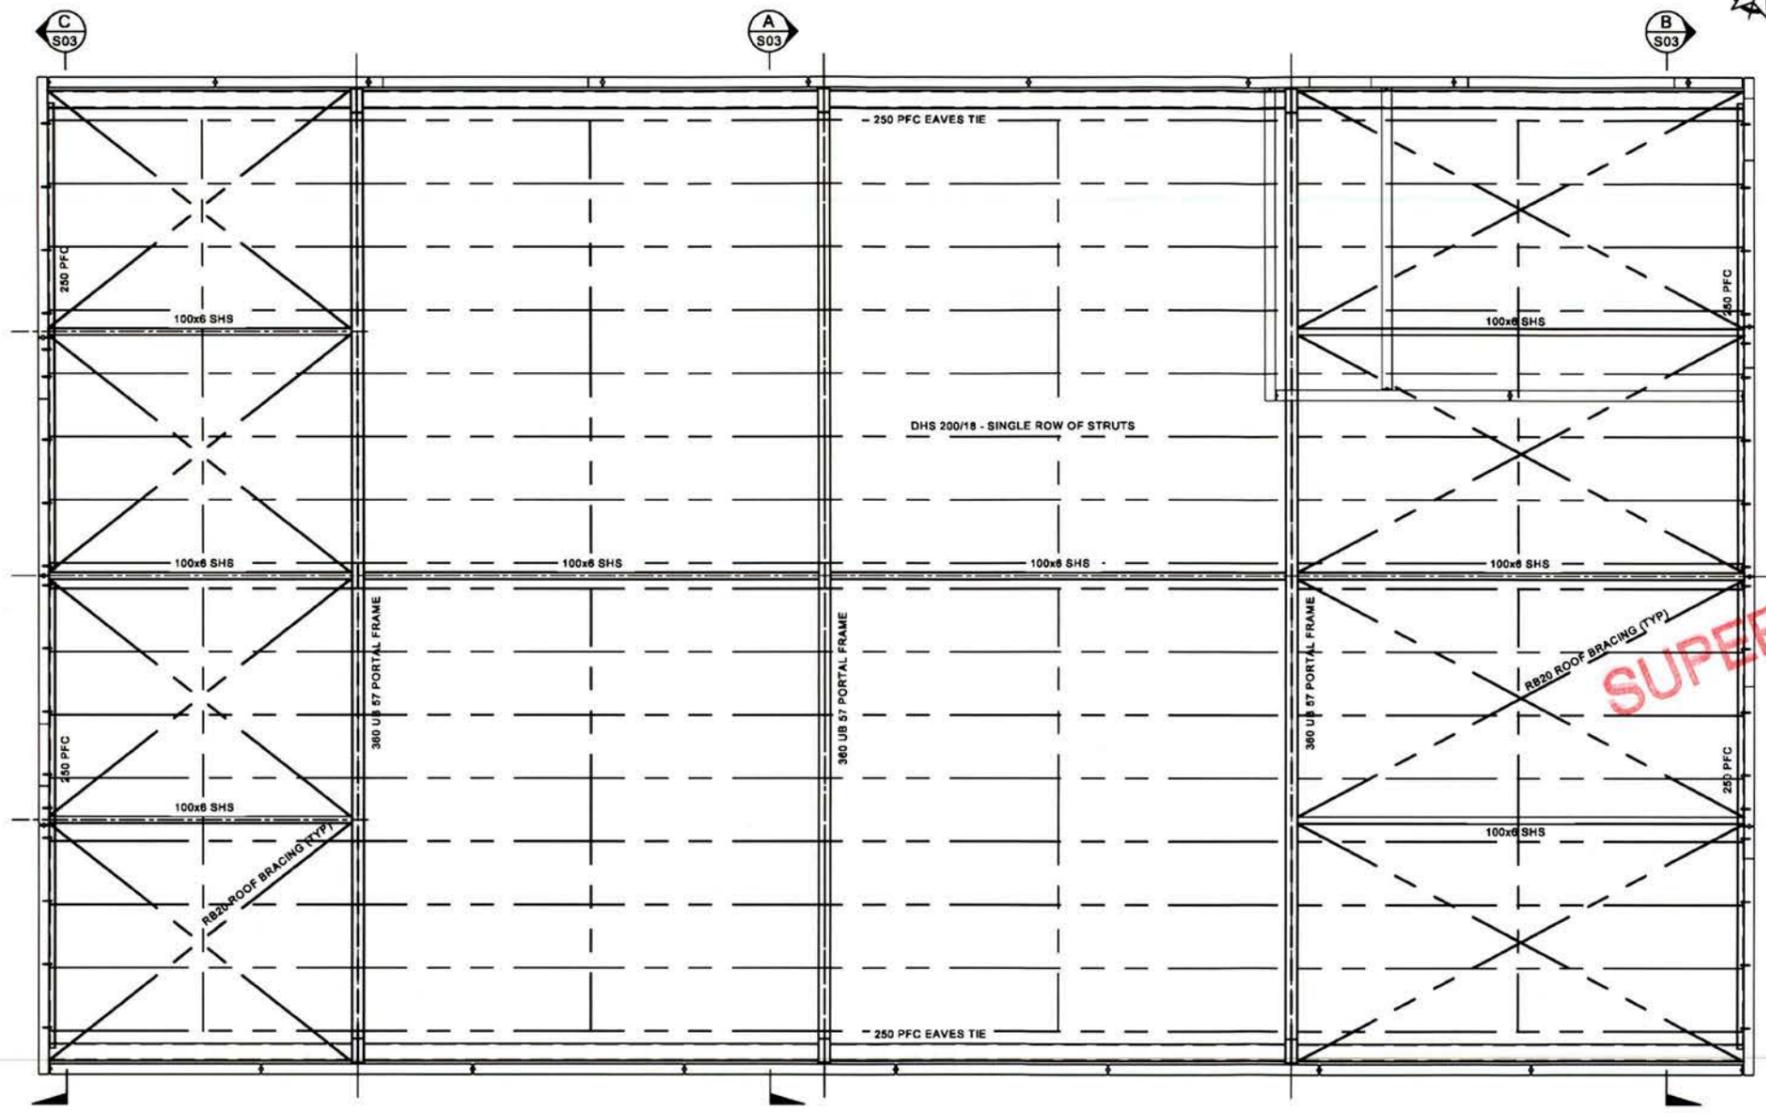

**STEELWORK PLAN**  
 1:50 at A1  
 1:100 at A3

**ROOF**  
 ROOF STRUCTURE SHALL BE AS FOLLOWS -  
 ROOFING KARAKA MARSHALL 6 LINE PROFILE.  
 THERMAKRAFT AUSMESH SAFETY NETTING.  
 COVERTEK 407 ROOF UNDERLAY  
 PINK BATTS R18 ROOF BLANKET.  
 TIMBER PURLINS SCREWED.  
 COVERTEK 401 ROOF UNDERLAY UNDER ROOFING.

- STEELWORK NOTES**
1. THE CONTRACTOR SHALL CONFIRM ALL DIMENSIONS AND LEVELS ON SITE PRIOR TO COMMENCING CONSTRUCTION.
  2. ALL PROPRIETARY FITTINGS SHALL BE INSTALLED STRICTLY TO MANUFACTURERS SPECIFICATIONS.
  3. ALL STEELWORK SHALL BE CLEANED TO SA2.5 AND PAINTED IN A SHOP ENVIRONMENT. REFER TO PAINT SPECIFICATION FOR SPECIFIC DETAILS.
  4. ALL SURFACES TO BE WELDED SHALL BE CLEANED OF ALL FOREIGN MATTER TO 50mm EACH SIDE OF THE WELD.
  5. ALL WELDS CONTINUOUS CATEGORY SP E41XXW40X UNLESS NOTED OTHERWISE.
  6. ALL WELDING SHALL BE 6mm FILLET WELDS ALL ROUND UNLESS NOTED OTHERWISE.
  7. ALL STRUCTURAL STEEL OPEN SECTION SHALL BE GRADE 300. ALL CLOSED SECTION SHS AND RHS SHALL BE GRADE 350. ALL BOLTS SHALL BE GALVANISED GRADE 8.8 WITH THREAD NOT PERMITTED WITHIN THE SHEAR PLANE AND TIGHTENED TO A SNUG TIGHT CONDITION (NIS).

**SUPERCEDED**

ORIGINAL SIZE (A1) DO NOT SCALE PLOT DATE 3-Dec-20

Rev No	ISSUED FOR CONSENT / CONSTRUCTION	ITB	DK	1:12:20
Rev No	REVISION DESCRIPTION	DRAWN	APPROVED	DATE
0	ISSUED FOR CONSENT / CONSTRUCTION	ITB	DK	1:12:20


	BY	DATE
DESIGNED	DK	10:20
DESIGN CHECK	DK	11:20
DRAWN	ITB	10:20
APPROVED		

**KENSINGTON CONSULTING**  
 Civil and Structural Engineers  
 03 218 7936 027 403 3773


**GORE WATER TREATMENT PLANT  
 UPGRADE - NEW BUILDING  
 STRUCTURAL STEEL PLAN**

STATUS		
CONSENT / CONSTRUCTION		
SCALE AT A1		
PROJECT NUMBER	DRAWING NUMBER	REV.
20080	S02	0


Gore District Council  
 20 JAN 2021  
 1:28 PM

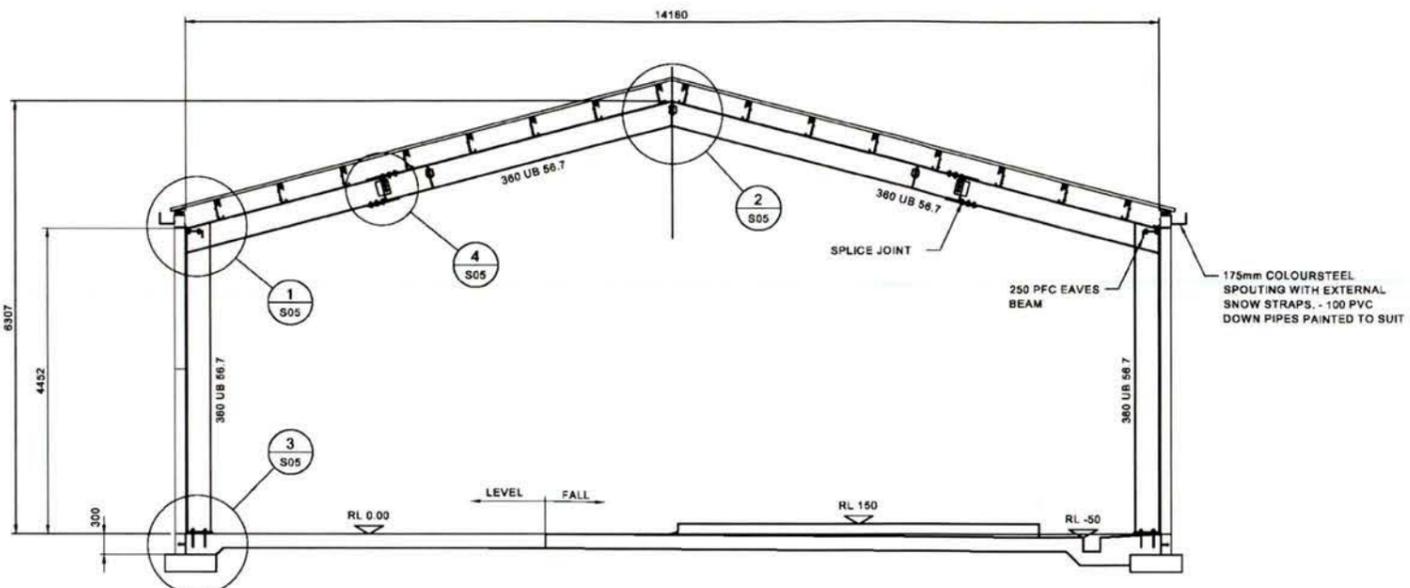


**SECTION A**  
 1:50 at A1  
 1:100 at A3

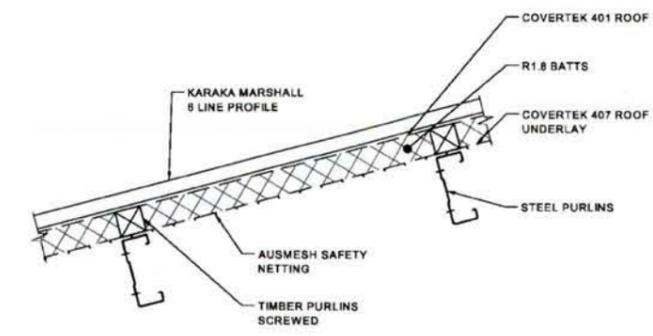

**ROOF DETAIL**  
 1:10 at A1  
 1:20 at A3

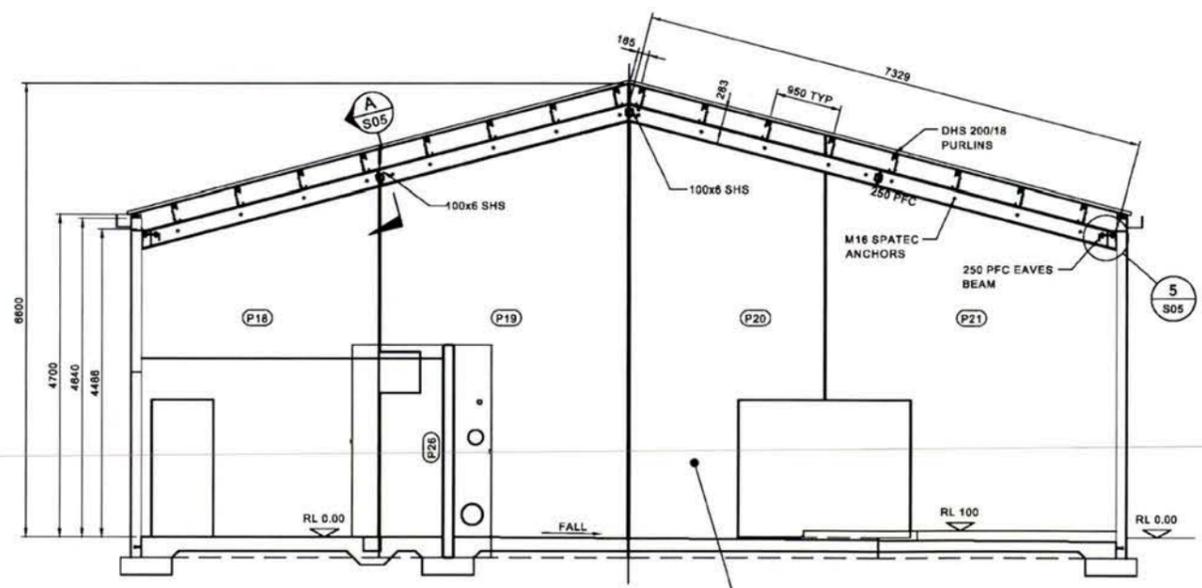

**SECTION B**  
 1:50 at A1  
 1:100 at A3

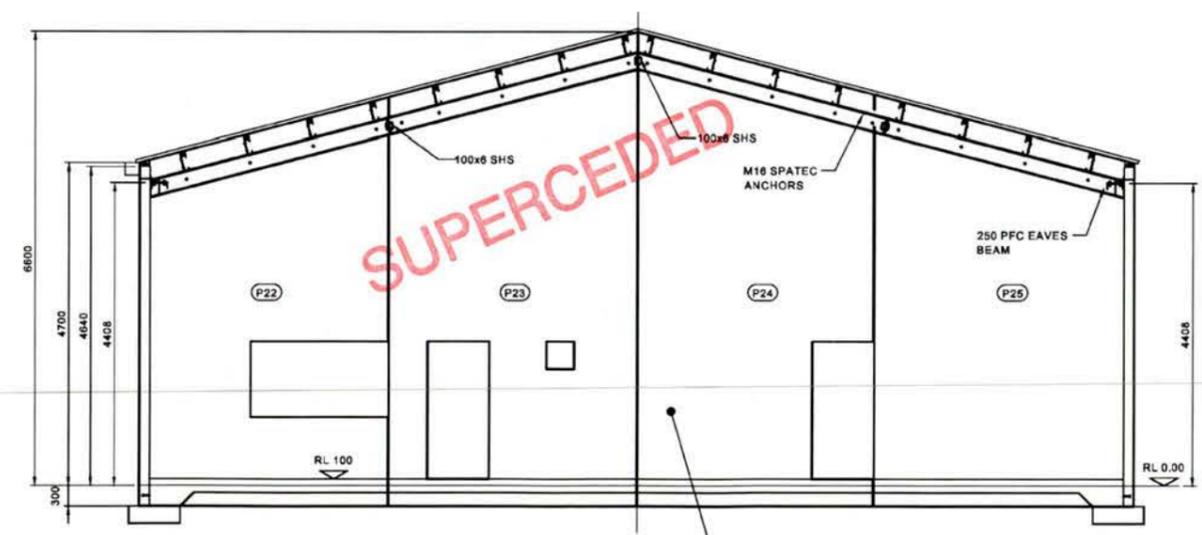

**SECTION C**  
 1:50 at A1  
 1:100 at A3

**SUPERCEDED**

**SUPERCEDED**

**SUPERCEDED**

Rev No	ISSUED FOR CONSENT / CONSTRUCTION	ITB	DK	1:12:20
Rev No	REVISION DESCRIPTION	DRAWN	APPROVED	DATE
0	ISSUED FOR CONSENT / CONSTRUCTION	ITB	DK	1:12:20

	BY	DATE
DESIGNED	DK	10:20
DESIGN CHECK	DK	11:20
DRAWN	ITB	10:20
APPROVED		

**KENSINGTON CONSULTING**  
 Civil and Structural Engineers  
 03 218 7936 027 403 3773






**GORE WATER TREATMENT PLANT  
 UPGRADE - NEW BUILDING  
 SECTIONS**

STATUS		
CONSENT / CONSTRUCTION		
SCALE AT A1		
PROJECT NUMBER	DRAWING NUMBER	REV.
20080	S03	0

RECEIVED  
 Gore District Council

20 JAN 2021  
 1:28 PM

**SUPERCEDED**

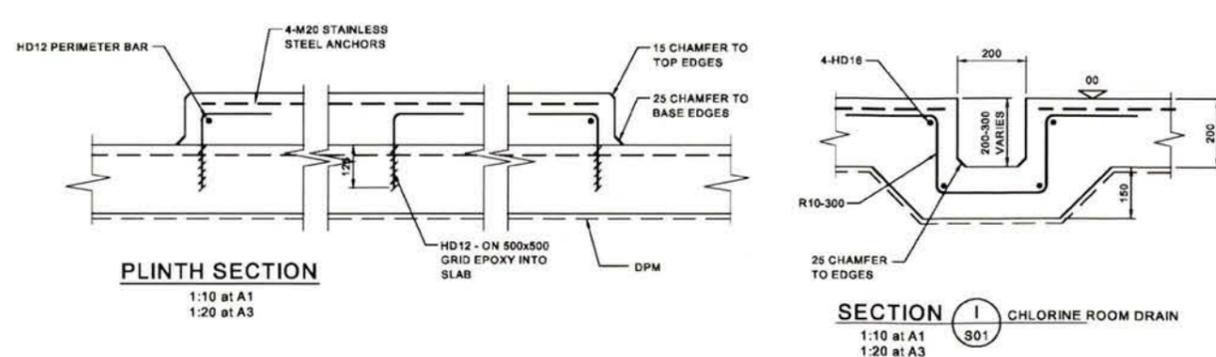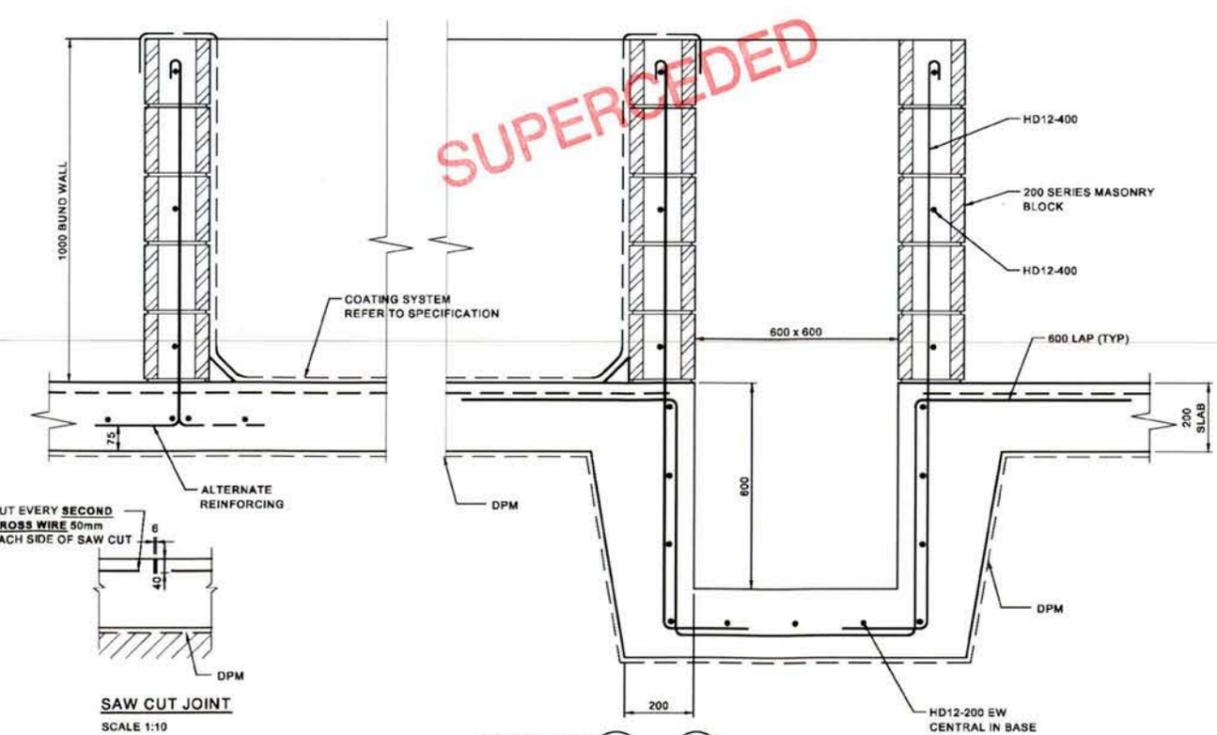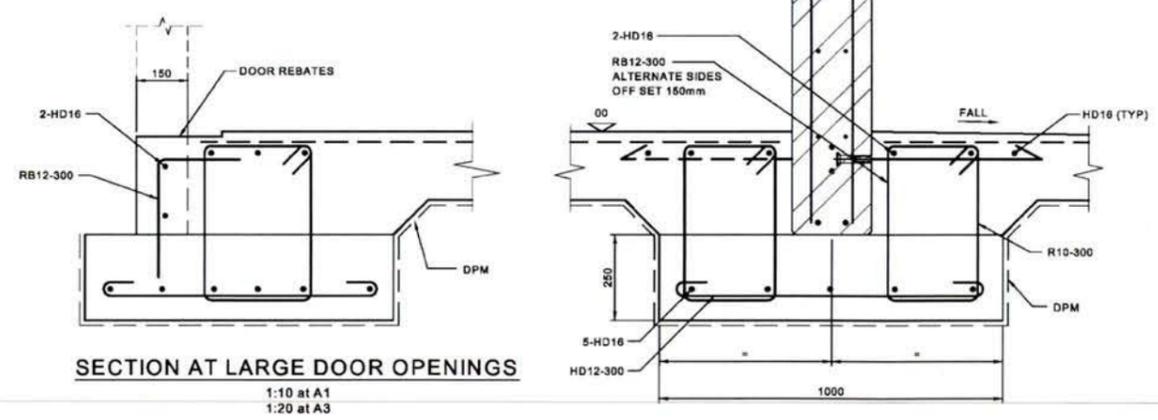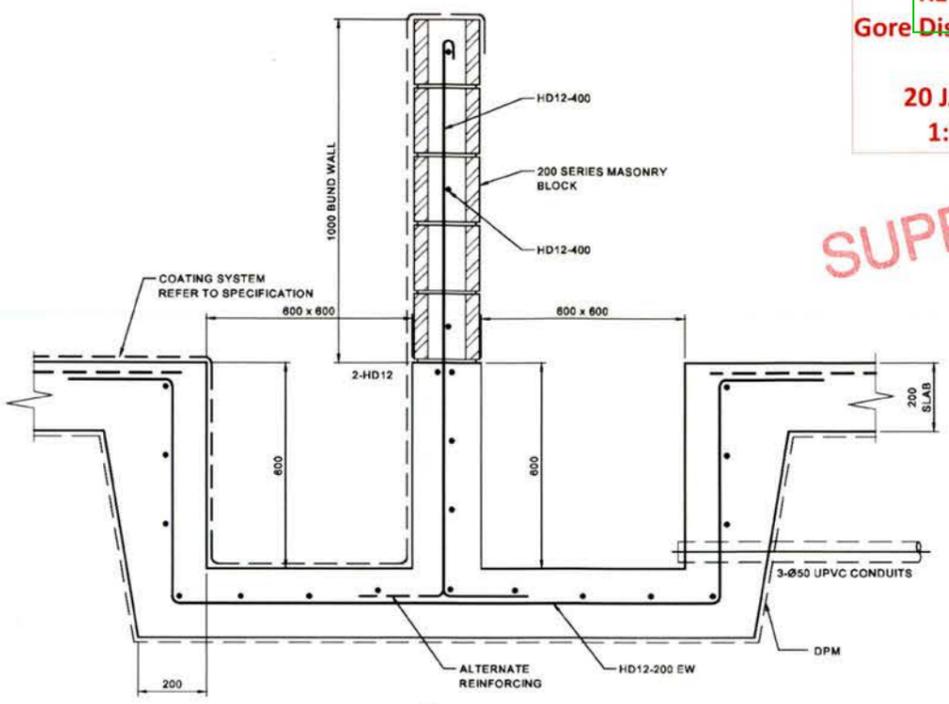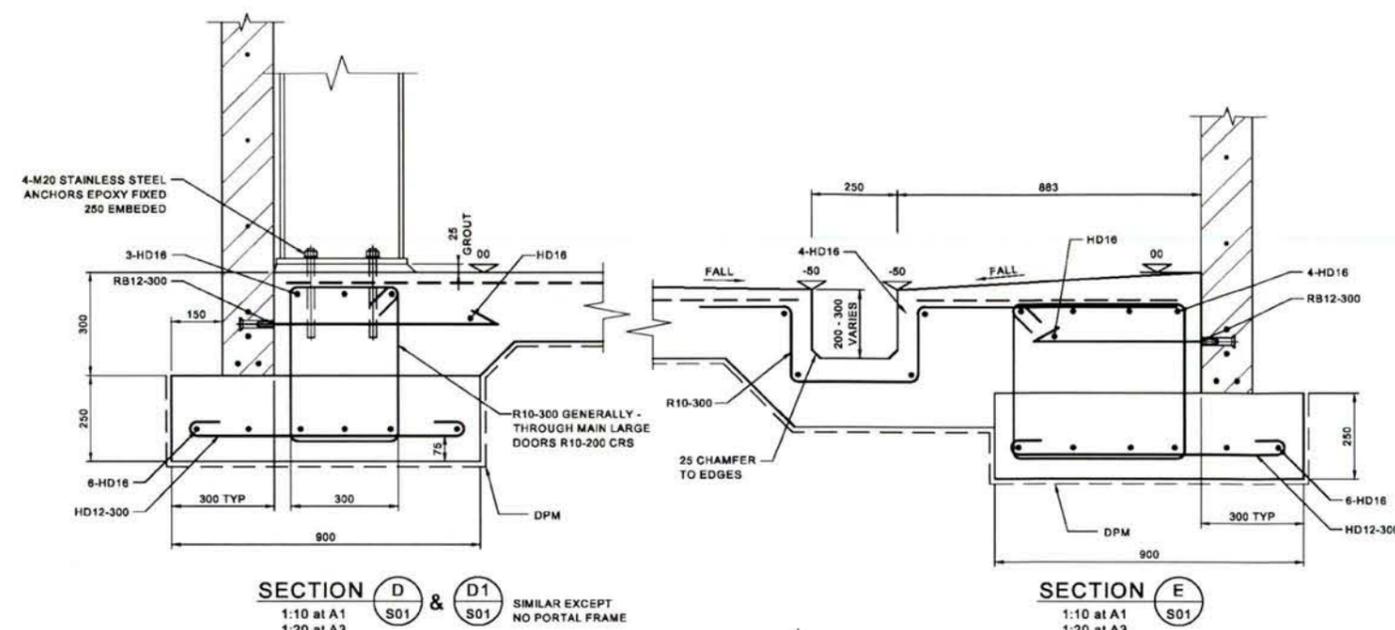

**SUPERCEDED**

Rev No	ISSUED FOR CONSENT / CONSTRUCTION	ITB	DK	1:12:20
	REVISION DESCRIPTION	DRAWN	APPROVED	DATE
0	ISSUED FOR CONSENT / CONSTRUCTION	ITB	DK	1:12:20

	BY	DATE
DESIGNED	DK	10:20
DESIGN CHECK	DK	11:20
DRAWN	ITB	10:20
APPROVED		

**KENSINGTON CONSULTING**  
 Civil and Structural Engineers  
 03 218 7936 027 403 3773






**GORE WATER TREATMENT PLANT  
 UPGRADE - NEW BUILDING  
 SECTIONS AND DETAILS**

STATUS		
CONSENT / CONSTRUCTION		
SCALE AT A1		
PROJECT NUMBER	DRAWING NUMBER	REV
20080	S04	0

RECEIVED  
 Gore District Council

20 JAN 2021  
 1:28 PM

**SUPERCEDED**

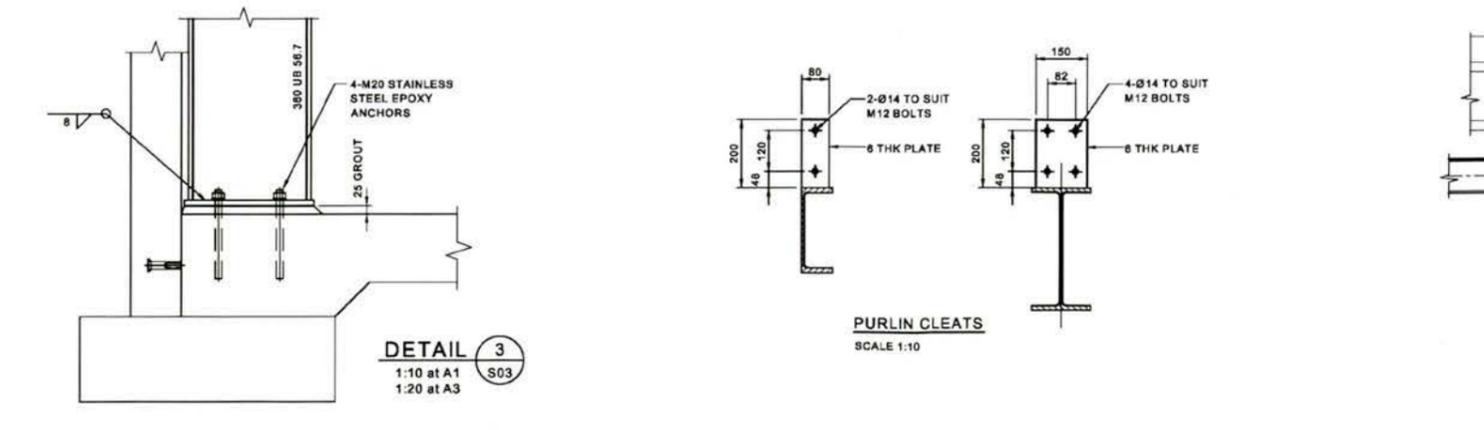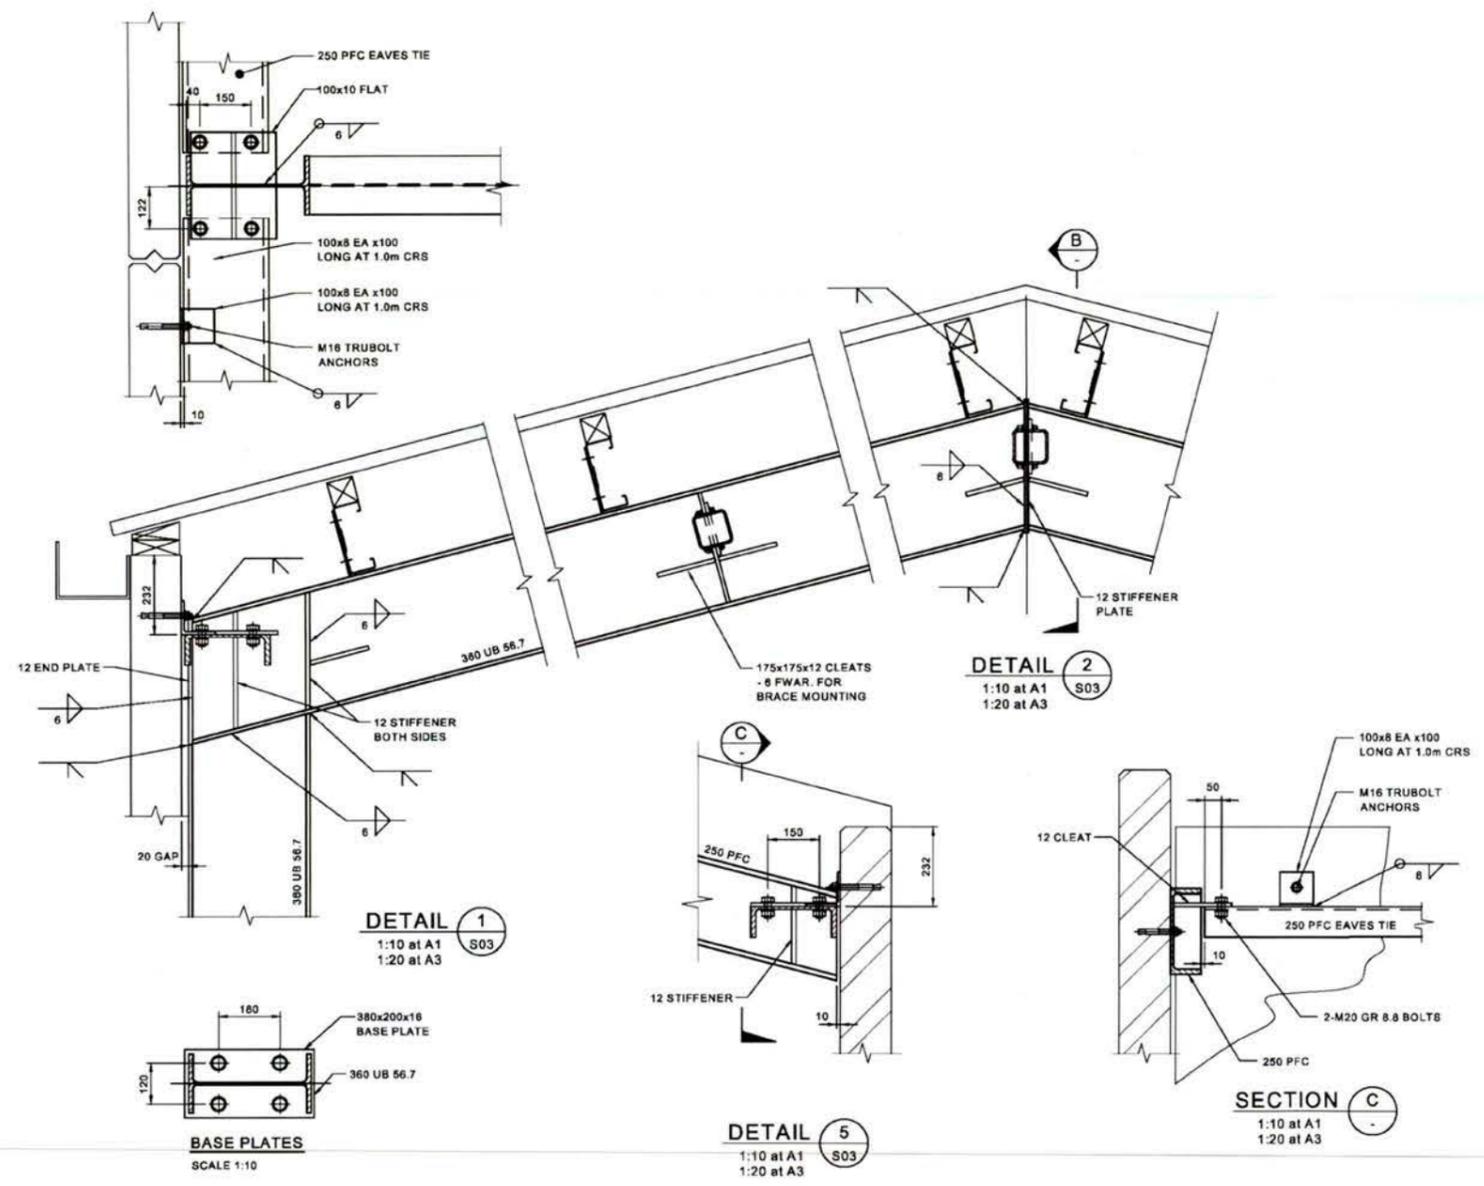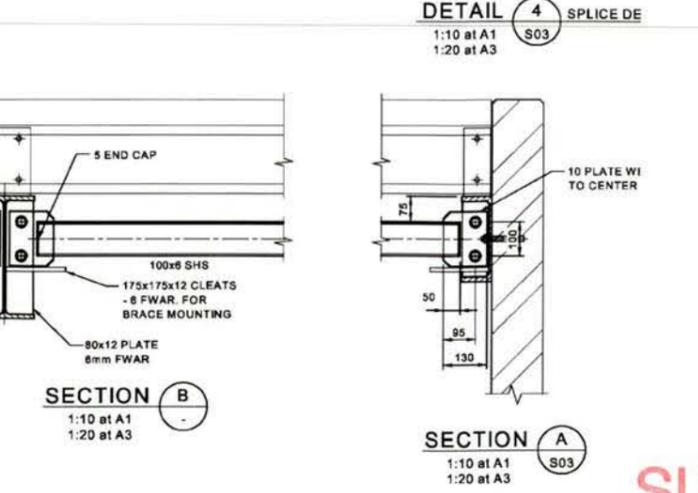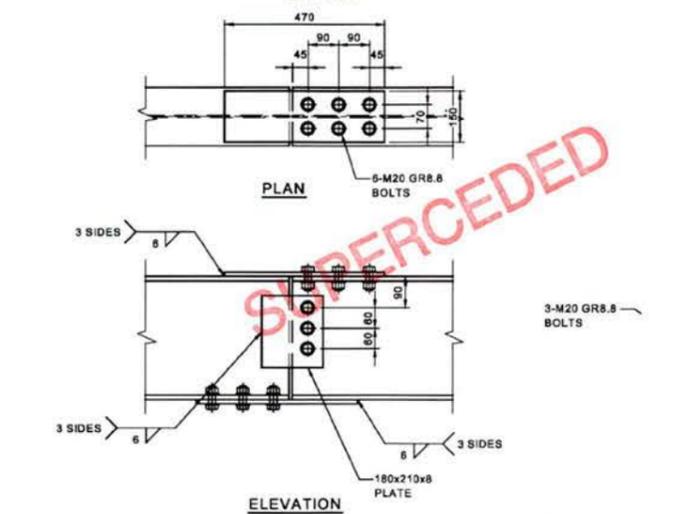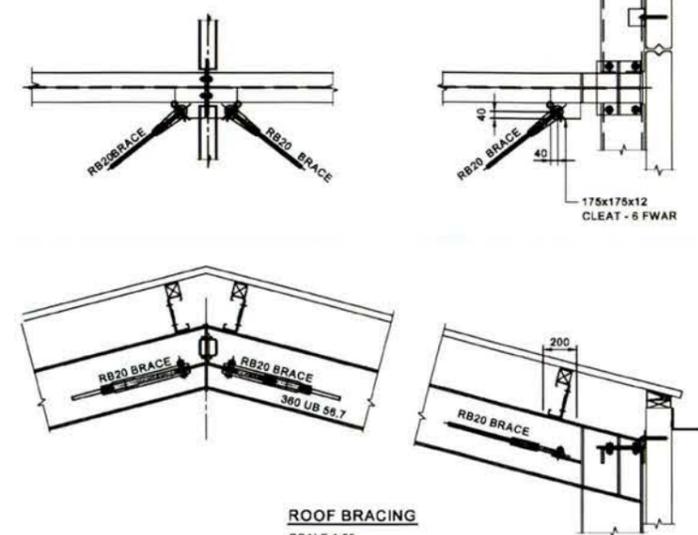

**SUPERCEDED**

Rev No	ISSUED FOR CONSENT / CONSTRUCTION	ITB	DK	1:12:20
Rev No	REVISION DESCRIPTION	DRAWN	APPROVED	DATE
0	ISSUED FOR CONSENT / CONSTRUCTION	ITB	DK	1:12:20

	BY	DATE
DESIGNED	DK	10:20
DESIGN CHECK	DK	11:20
DRAWN	ITB	10:20
APPROVED		

**KENSINGTON CONSULTING**  
 Civil and Structural Engineers  
 03 218 7936 027 403 3773


**GORE WATER TREATMENT PLANT  
 UPGRADE - NEW BUILDING  
 SECTIONS AND DETAILS**

STATUS		
CONSENT / CONSTRUCTION		
SCALE AT A1		
PROJECT NUMBER	DRAWING NUMBER	REV
20080	S05	0


RECEIVED  
 Gore District Council

20 JAN 2021  
 1:28 PM

**SUPERCEDED**

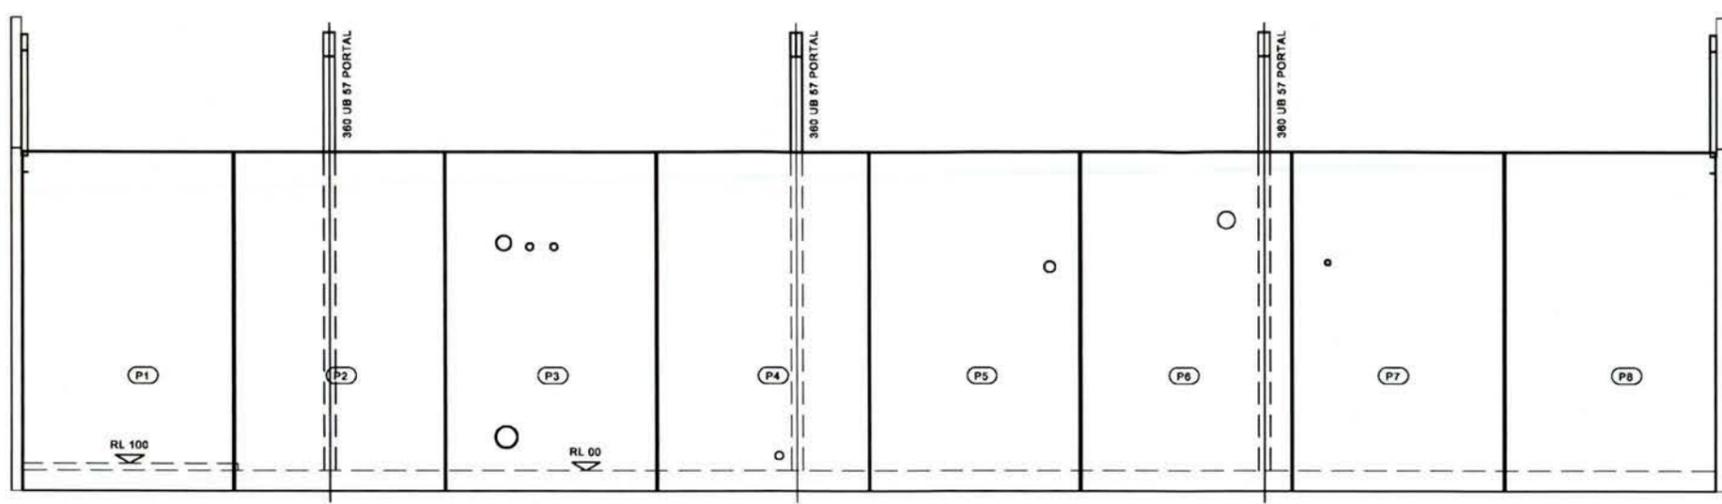

**SOUTH WALL ELEVATION** REFER TO S10 FOR PANEL DETAILS  
 1:50 at A1  
 1:100 at A3

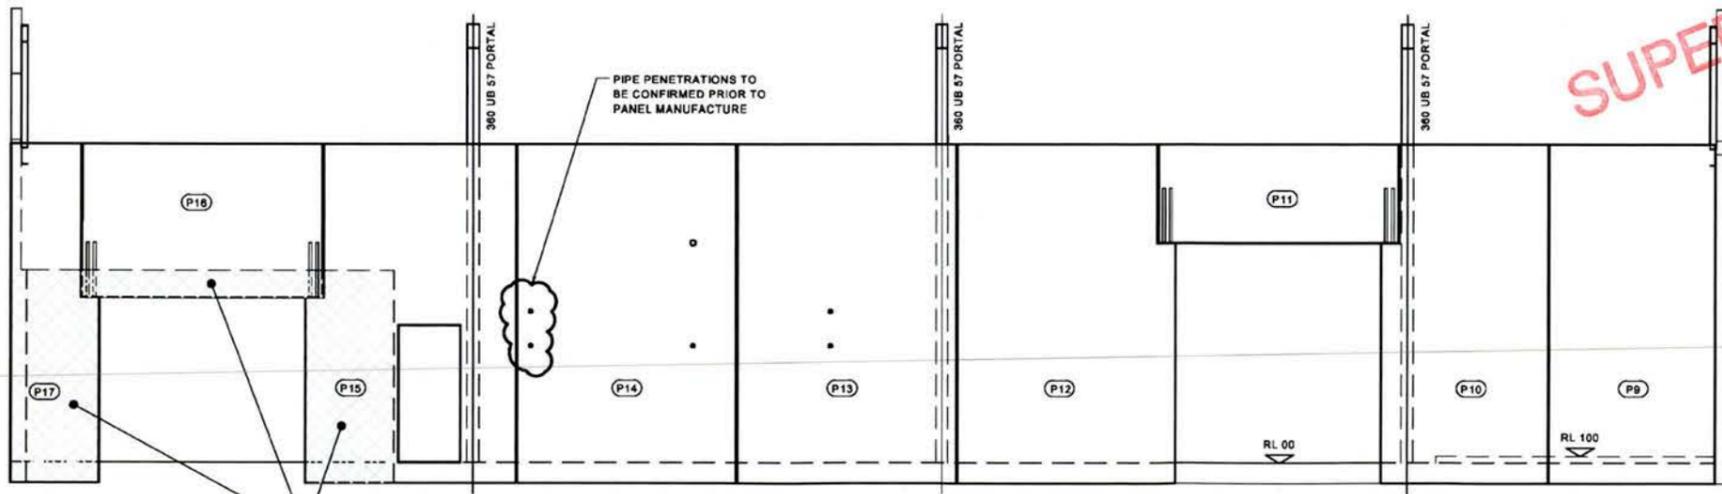

**NORTH WALL ELEVATION** REFER TO S09 FOR PANEL DETAILS  
 1:50 at A1  
 1:100 at A3

**SUPERCEDED**

**SUPERCEDED**

Rev No	ISSUED FOR CONSENT / CONSTRUCTION	ITB	DK	1:12:20
Rev No	REVISION DESCRIPTION	DRAWN	APPROVED	DATE
0	ISSUED FOR CONSENT / CONSTRUCTION	ITB	DK	1:12:20

	BY	DATE
DESIGNED	DK	10:20
DESIGN CHECK	DK	11:20
DRAWN	ITB	10:20
APPROVED		

**KENSINGTON CONSULTING**  
 Civil and Structural Engineers  
 03 218 7936 027 403 3773


GORE WATER TREATMENT PLANT  
 UPGRADE - NEW BUILDING  
 PRECAST PANELS  
 NORTH & SOUTH WALL ELEVATIONS

STATUS CONSENT / CONSTRUCTION		
SCALE AT A1		
PROJECT NUMBER	DRAWING NUMBER	REV.
20080	S06	0



20 JAN 2021  
 1:28 PM

**SUPERCEDED**


ORIGINAL SIZE (A1) DO NOT SCALE PLOT DATE 3-Dec-20 ORIGINAL SIZE (A1) DO NOT SCALE

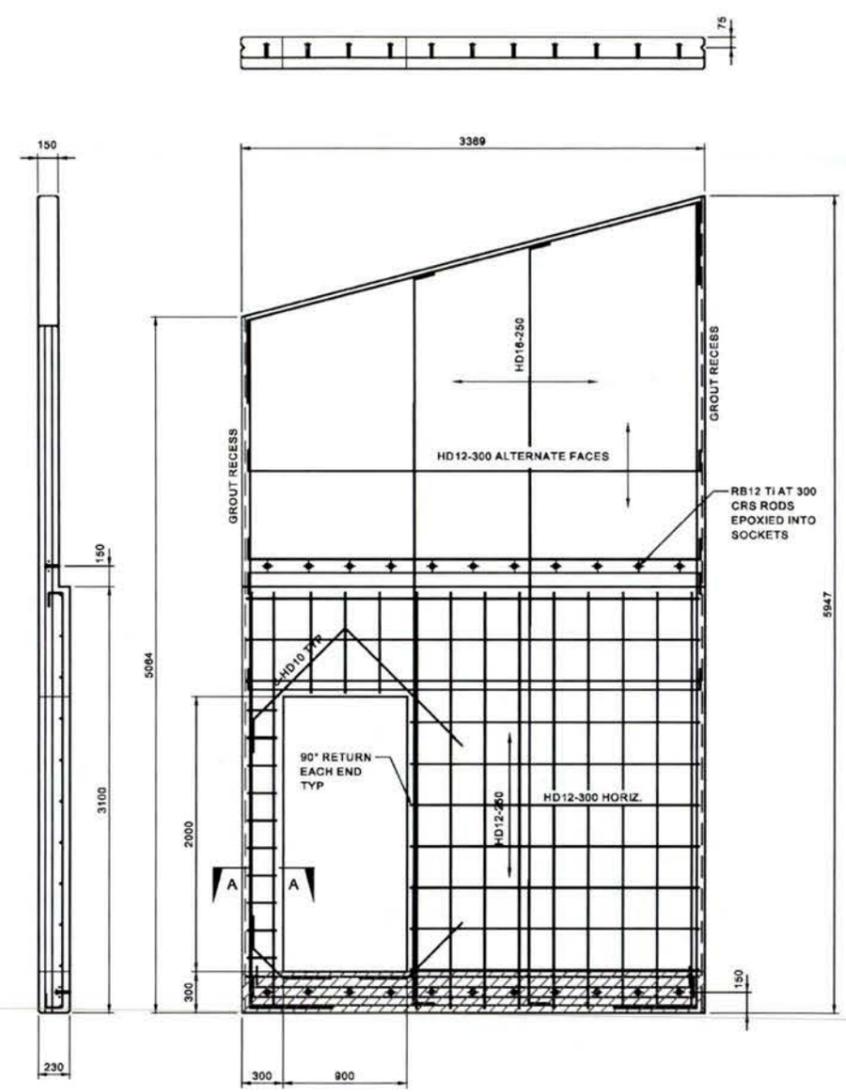

**P18** VIEWED FROM INSIDE

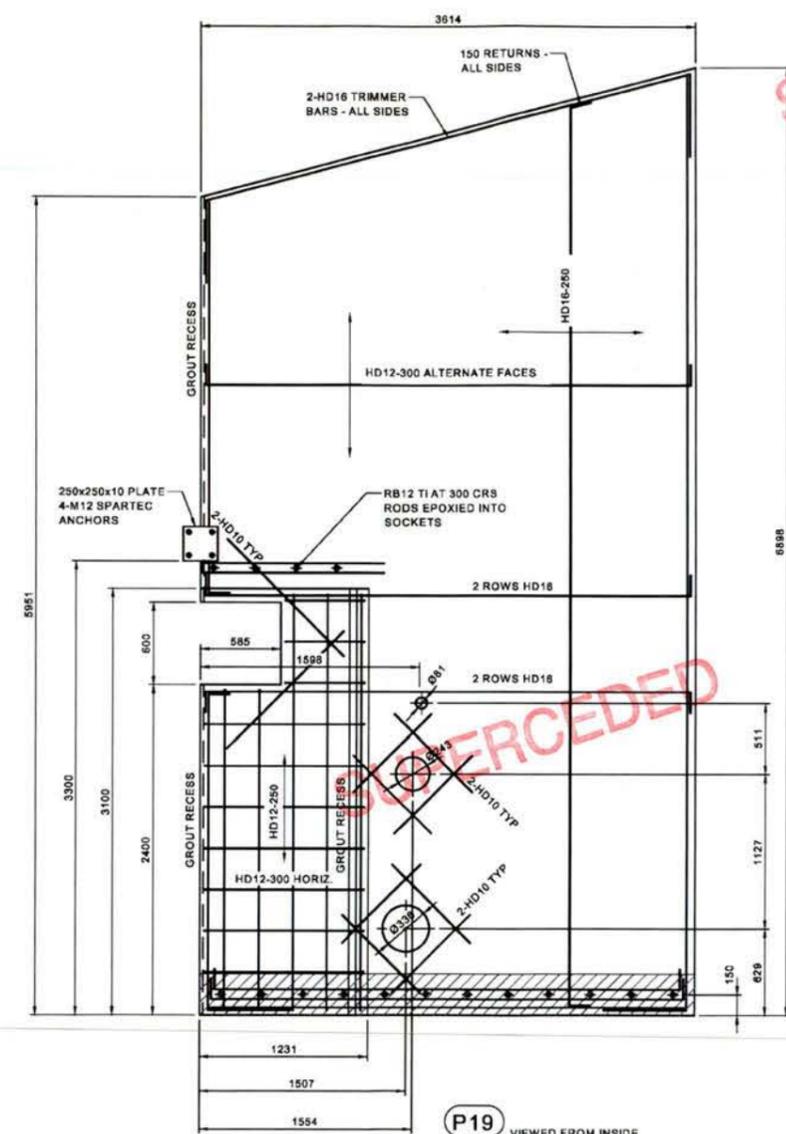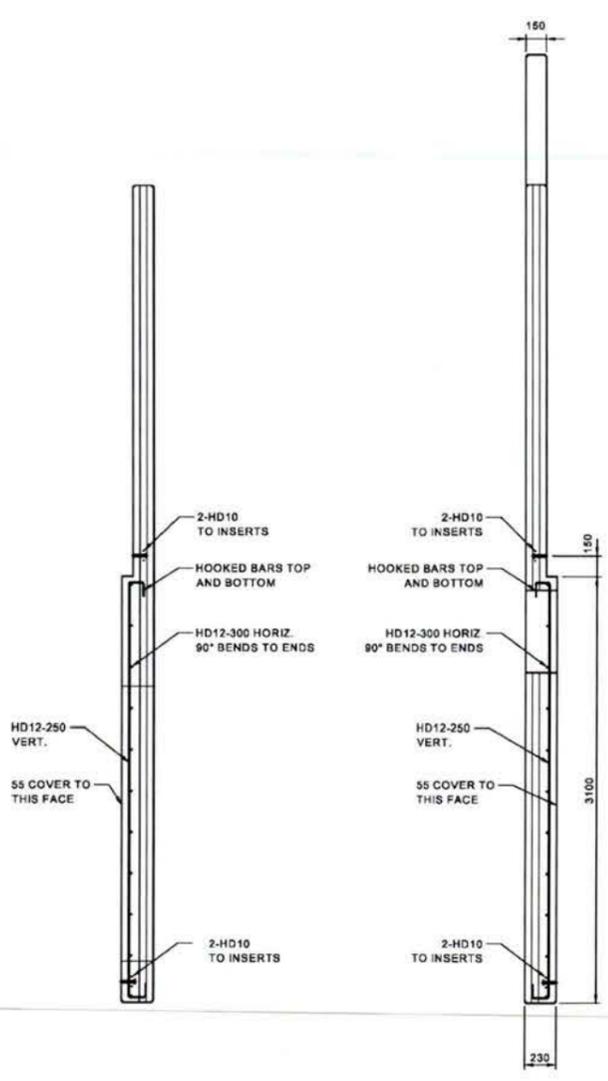

**P19** VIEWED FROM INSIDE

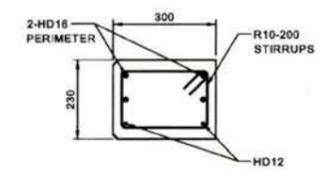

**SECTION A-A**  
 SCALE 1:10

**SUPERCEDED**

Rev No	ISSUED FOR CONSENT / CONSTRUCTION	ITB	DK	1:12:20
Rev No	REVISION DESCRIPTION	DRAWN	APPROVED	DATE
0	ISSUED FOR CONSENT / CONSTRUCTION	ITB	DK	1:12:20

	BY	DATE
DESIGNED	DK	10-20
DESIGN CHECK	DK	11-20
DRAWN	ITB	10-20
APPROVED		


**KENSINGTON CONSULTING**  
 Civil and Structural Engineers  
 03 218 7936 027 403 3773

**GORE WATER TREATMENT PLANT  
 UPGRADE - NEW BUILDING  
 EAST WALL PRECAST PANELS  
 DETAILS**


STATUS		
CONSENT / CONSTRUCTION		
SCALE AT A1		
PROJECT NUMBER	DRAWING NUMBER	REV.
20080	S07A	0

RECEIVED  
 Gore District Council  
 20 JAN 2021  
 1:28 PM

**SUPERCEDED**

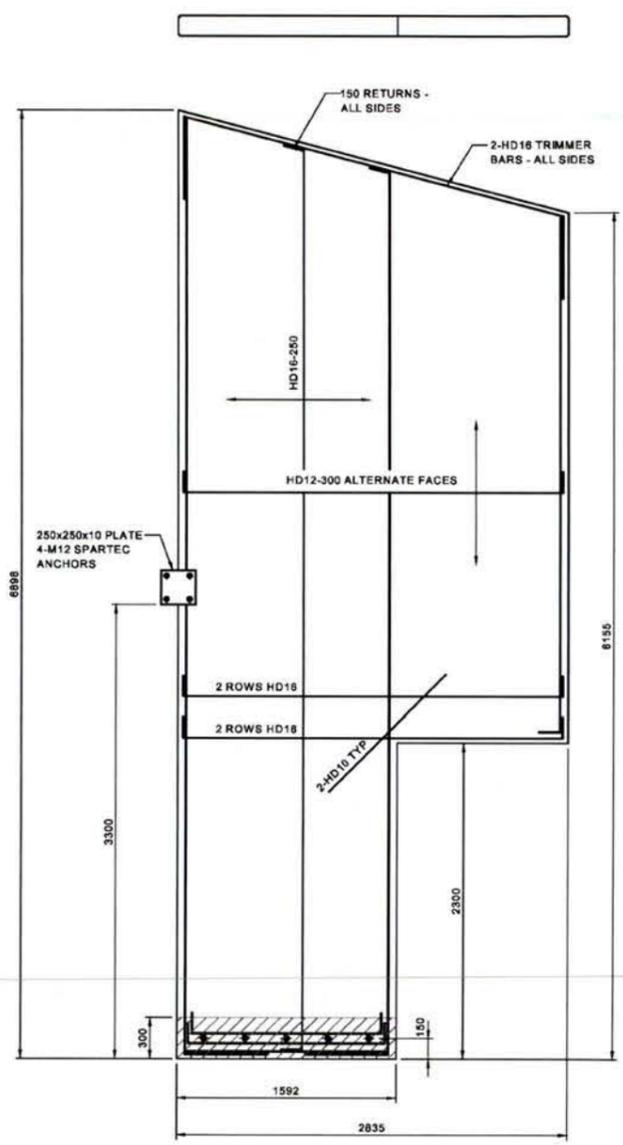

**P20**  
 VIEWED FROM INSIDE

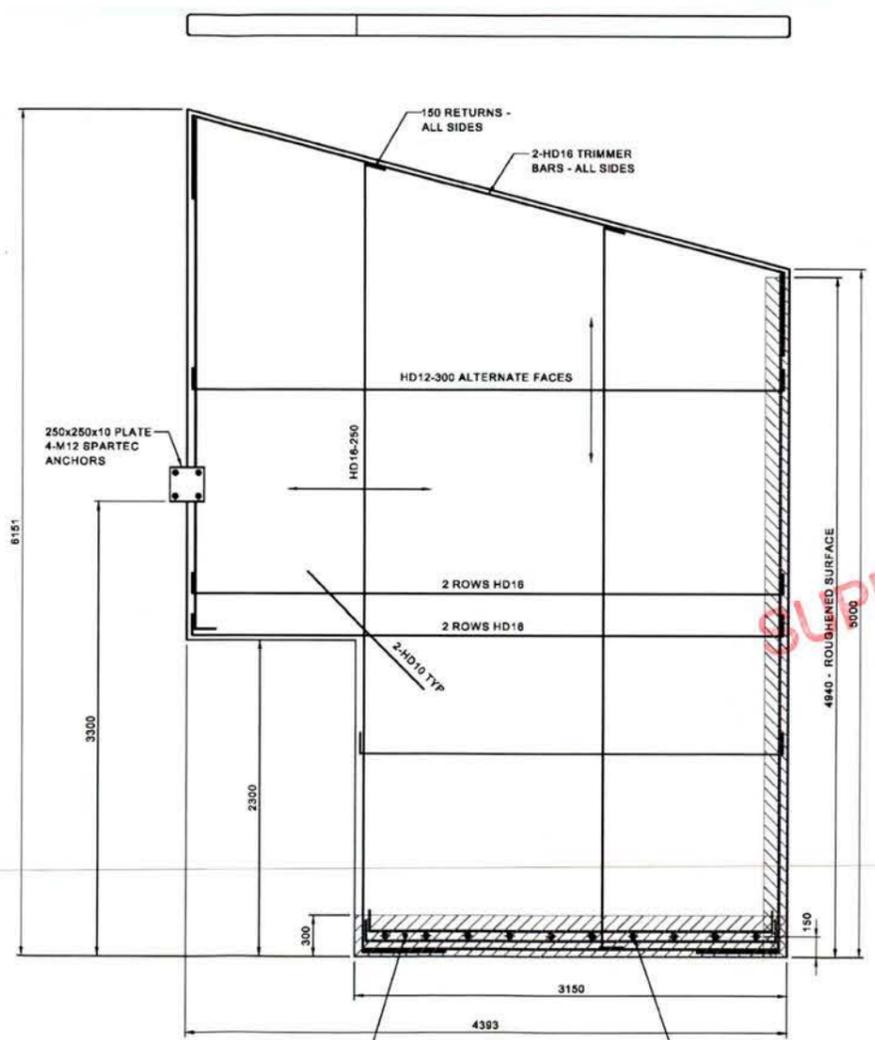

**P21**  
 VIEWED FROM INSIDE

**EAST WALL PANELS**  
 1:25 at A1  
 1:50 at A3

**SUPERCEDED**

**SUPERCEDED**

Rev No	ISSUED FOR CONSENT / CONSTRUCTION	ITB	DK	1:12:20
Rev No	REVISION DESCRIPTION	DRAWN	APPROVED	DATE
0	ISSUED FOR CONSENT / CONSTRUCTION	ITB	DK	1:12:20

	BY	DATE
DESIGNED	DK	10:20
DESIGN CHECK	DK	11:20
DRAWN	ITB	10:20
APPROVED		

**KENSINGTON CONSULTING**  
 Civil and Structural Engineers  
 03 218 7936 027 403 3773


**GORE WATER TREATMENT PLANT  
 UPGRADE - NEW BUILDING  
 EAST WALL PRECAST PANELS  
 DETAILS**

STATUS		
CONSENT / CONSTRUCTION		
SCALE AT A1		
PROJECT NUMBER	DRAWING NUMBER	REV.
20080	S07B	0

RECEIVED  
 Gore District Council  
 20 JAN 2021  
 1:28 PM

**SUPERCEDED**

ORIGINAL SIZE (A1) DO NOT SCALE PLOT DATE: 3-Dec-20

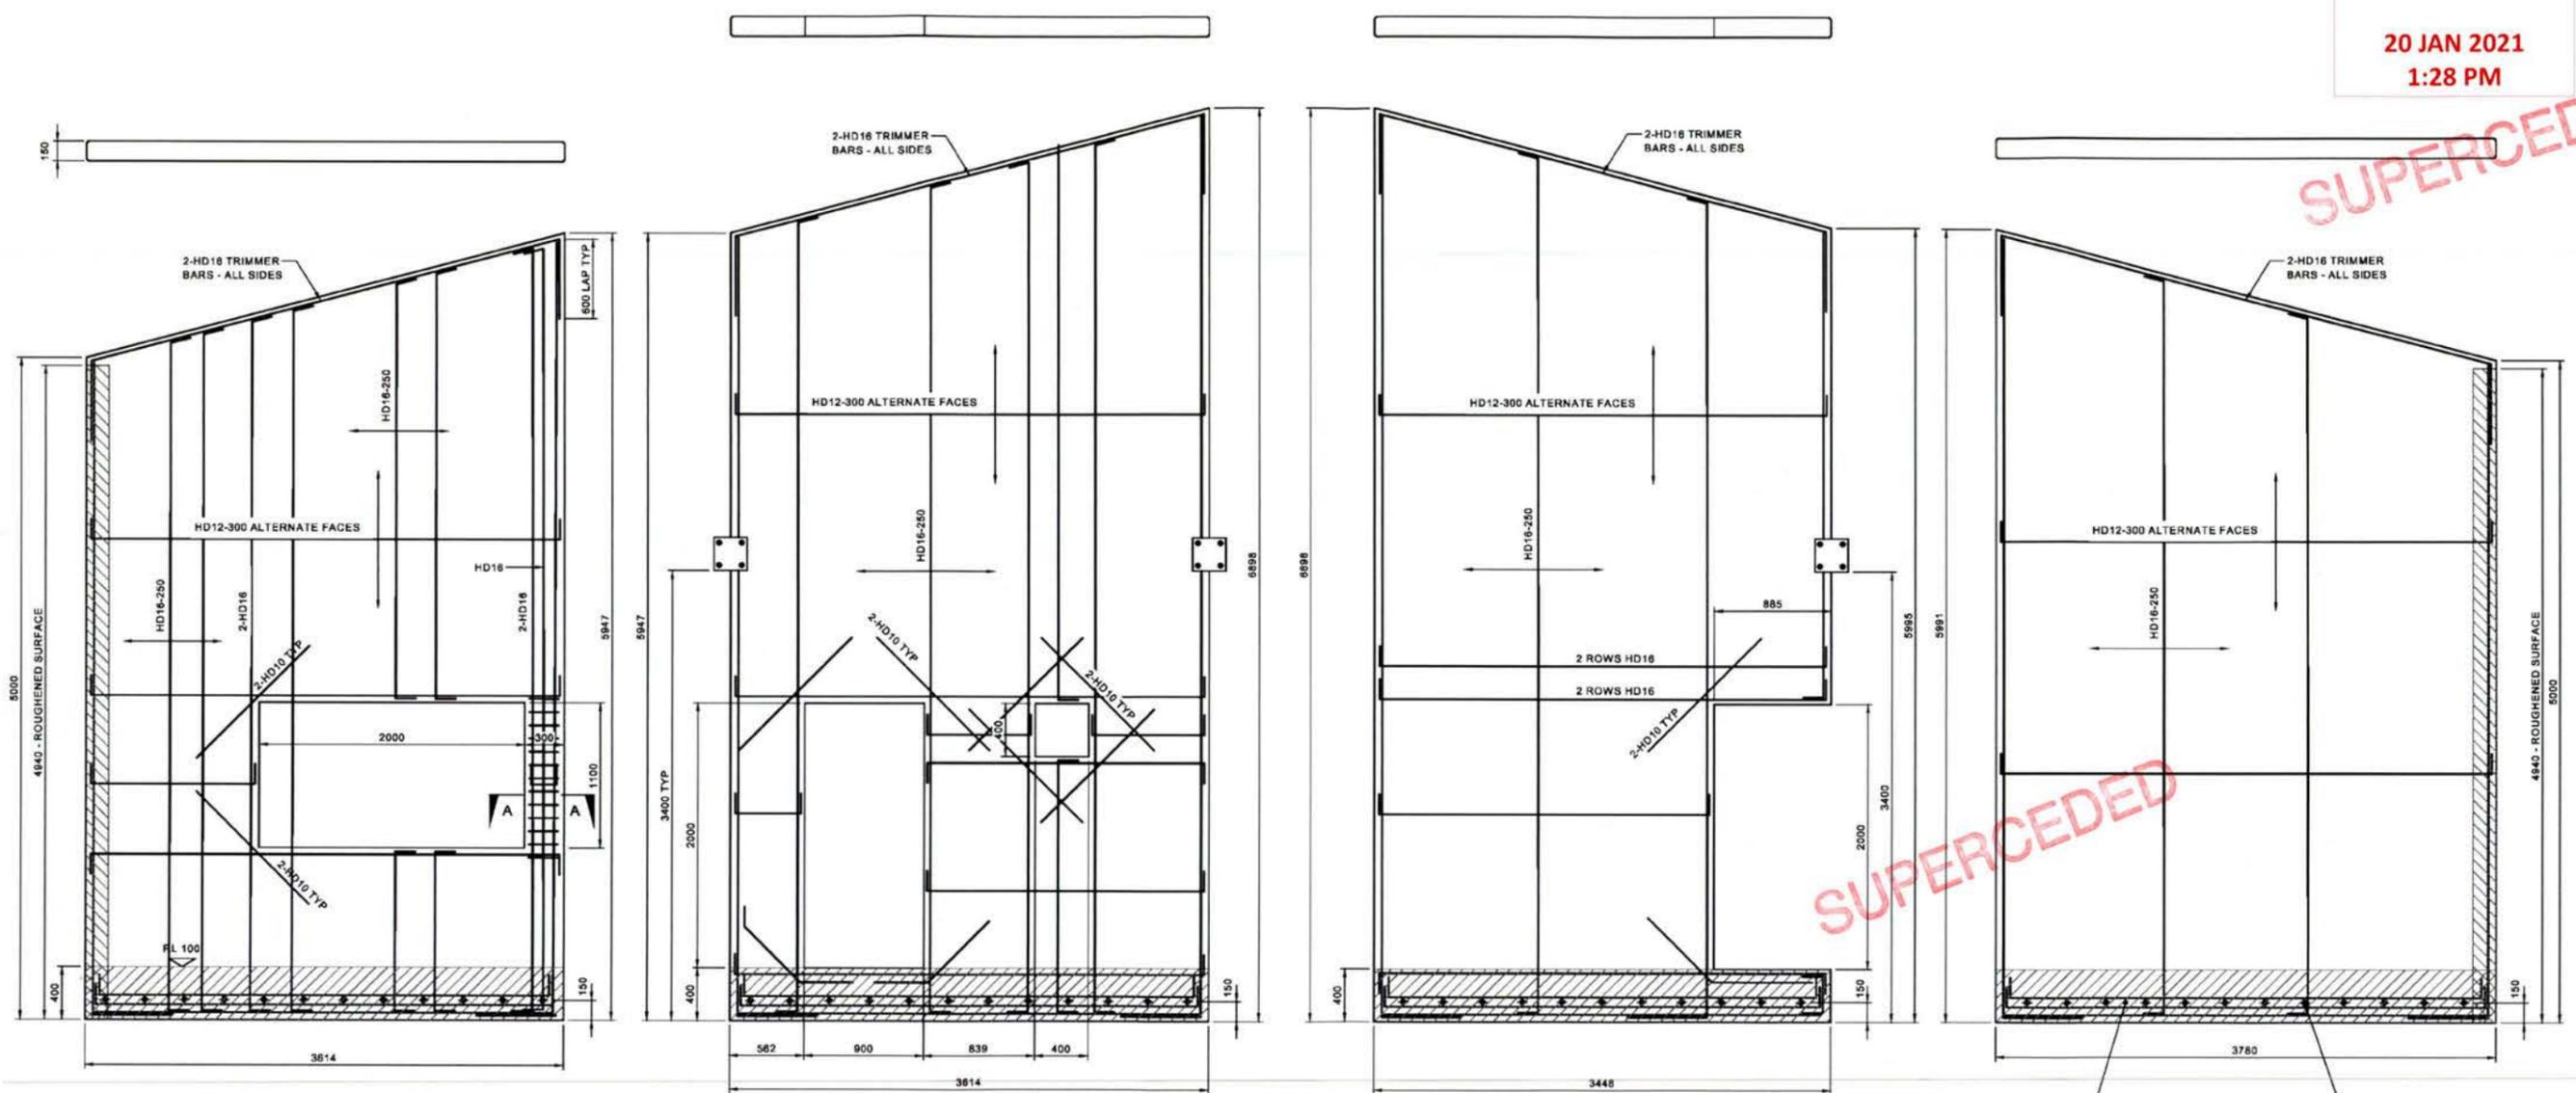

**SUPERCEDED**


**P22**  
 VIEWED FROM INSIDE

**P23**  
 VIEWED FROM INSIDE

**P24**  
 VIEWED FROM INSIDE

**P25**  
 VIEWED FROM INSIDE

HATCHED SURFACE RETARDED TO ACHIEVE FULL 5mm AMPLITUDE ROUGHNESS.  
 1 ROWS RB12TI INSERTS AT 300 CRS C/W ALL RODS TO BE EPOXIED AND SCREWED INTO SOCKETS - USE C6 OR APPROVED EQUAL (TYPICAL ALL ANCHORAGES)

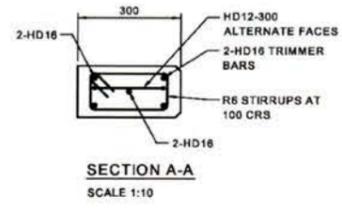

**WEST WALL PANELS**  
 1:25 at A1  
 1:50 at A3

**SUPERCEDED**

Rev No	ISSUED FOR CONSENT / CONSTRUCTION	ITB	DK	1:12:20
Rev No	REVISION DESCRIPTION	DRAWN	APPROVED	DATE
0	ISSUED FOR CONSENT / CONSTRUCTION	ITB	DK	1:12:20

	BY	DATE
DESIGNED	DK	10:20
DESIGN CHECK	DK	11:20
DRAWN	ITB	10:20
APPROVED		

**KENSINGTON CONSULTING**  
 Civil and Structural Engineers  
 03 218 7936 027 403 3773


**GORE WATER TREATMENT PLANT  
 UPGRADE - NEW BUILDING  
 WEST WALL PRECAST PANELS  
 DETAILS**

STATUS		
CONSENT / CONSTRUCTION		
SCALE AT A1		
PROJECT NUMBER	DRAWING NUMBER	REV
20080	S08	0


Gore District Council  
 20 JAN 2021  
 1:28 PM

**SUPERCEDED**


ORIGINAL SIZE (A1) DO NOT SCALE PLOT DATE 3-09-23

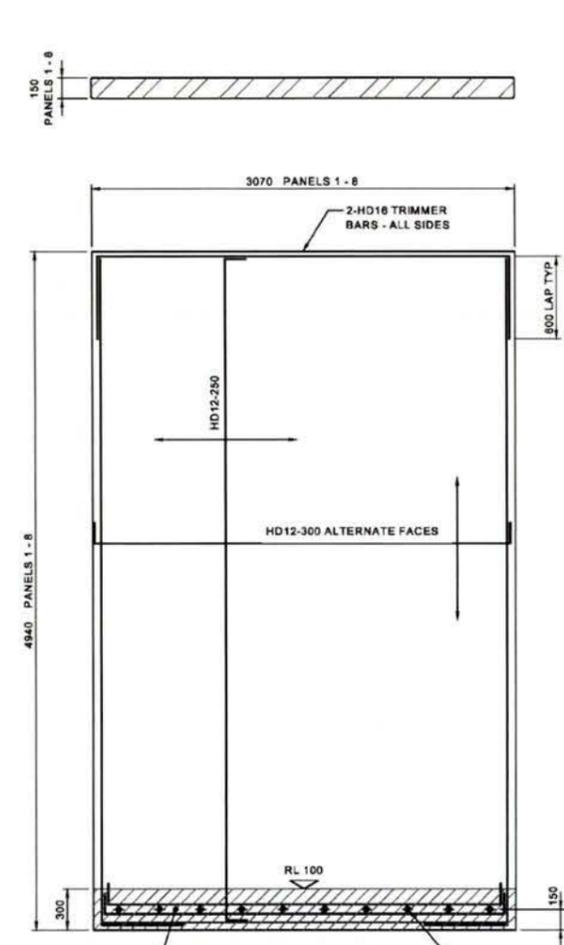


HATCHED SURFACE RETARDED TO ACHIEVE FULL 5mm AMPLITUDE ROUGHNESS.  
 P1 P2 P8  
 VIEWED FROM INSIDE  
 REINFORCING THE SAME FOR PANELS 1 - 8  
 1 ROWS RB12TI INSERTS AT 300 CRS C/W ALL RODS TO BE EPOXIED AND SCREWED INTO SOCKETS - USE C6 OR APPROVED EQUAL. (TYPICAL ALL ANCHORAGES)

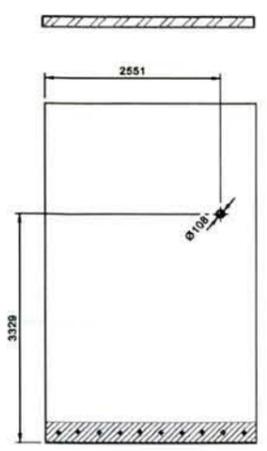


P7  
 VIEWED FROM INSIDE

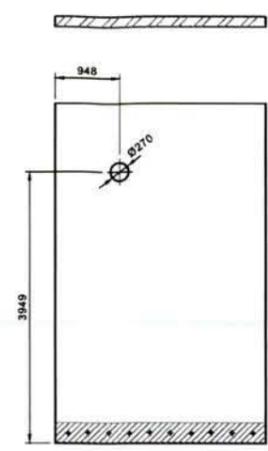


P6  
 VIEWED FROM INSIDE

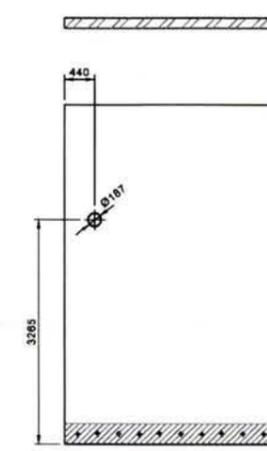


P5  
 VIEWED FROM INSIDE

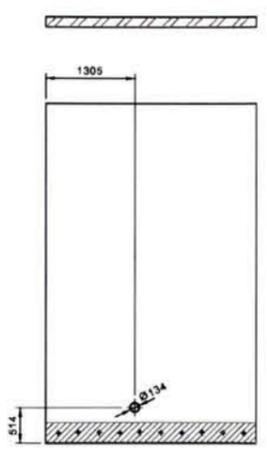


P4  
 VIEWED FROM INSIDE

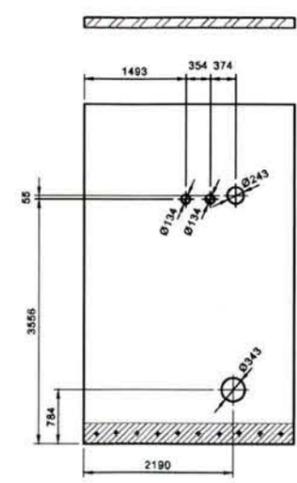


P3  
 VIEWED FROM INSIDE

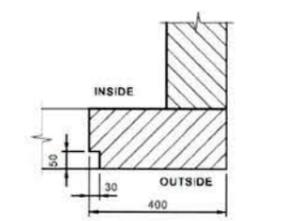


DOOR JAMB DETAIL  
 1:10 at A1  
 1:20 at A3

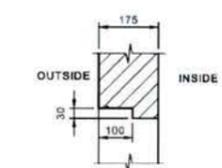

WINDOW HEAD DETAIL  
 1:10 at A1  
 1:20 at A3

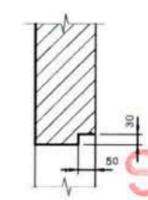


DOOR HEAD DETAIL  
 1:10 at A1  
 1:20 at A3

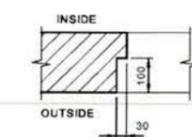


WINDOW SILL DETAIL  
 1:10 at A1  
 1:20 at A3

**SOUTH WALL PANELS**  
 1:50 at A1  
 1:100 at A3

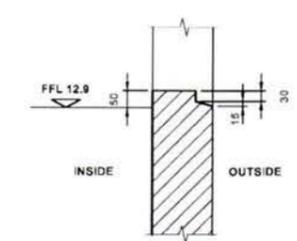


DOOR SILL DETAIL  
 1:10 at A1  
 1:20 at A3

WINDOW JAMB DETAIL  
 1:10 at A1  
 1:20 at A3

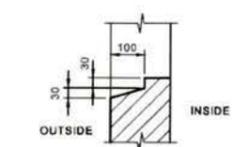

WINDOW JAMB DETAIL  
 1:10 at A1  
 1:20 at A3

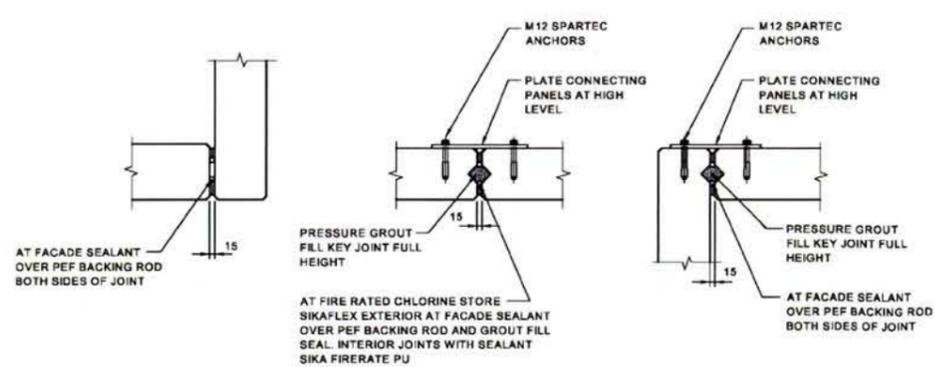

PANELS 13, 14, 15, 17, 18, 19, 26, 27 & 29  
 PANEL - PANEL CONNECTIONS

Rev No	ISSUED FOR CONSENT / CONSTRUCTION	ITB	DK	1:12:20
Rev No	REVISION DESCRIPTION	DRAWN	APPROVED	DATE
0	ISSUED FOR CONSENT / CONSTRUCTION	ITB	DK	1:12:20

	BY	DATE
DESIGNED	DK	10:20
DESIGN CHECK	DK	11:20
DRAWN	ITB	10:20
APPROVED		


**KENSINGTON CONSULTING**  
 Civil and Structural Engineers  
 03 218 7936 027 403 3773

**GORE WATER TREATMENT PLANT  
 UPGRADE - NEW BUILDING  
 SOUTH WALL PRECAST PANELS  
 AND PANEL CONNECTION DETAILS**


STATUS		
CONSENT / CONSTRUCTION		
SCALE AT A1		
PROJECT NUMBER	DRAWING NUMBER	REV.
20080	S09	0

RECEIVED  
 Gore District Council  
 20 JAN 2021  
 1:28 PM


**SUPERCEDED**

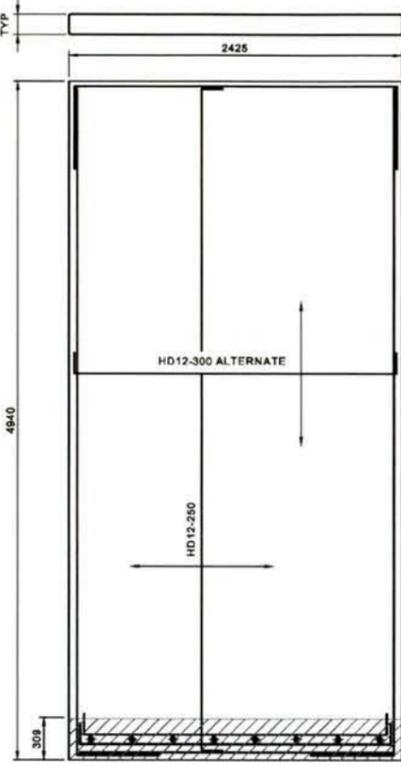


P9 VIEWED FROM INSIDE

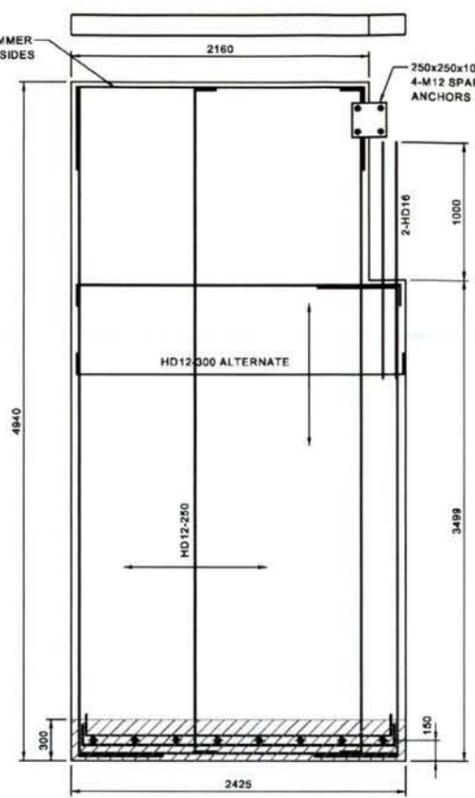


P10 VIEWED FROM INSIDE

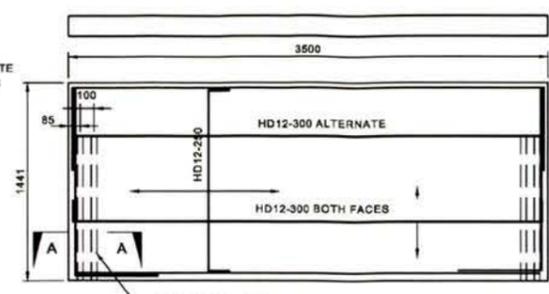


P11 VIEWED FROM INSIDE

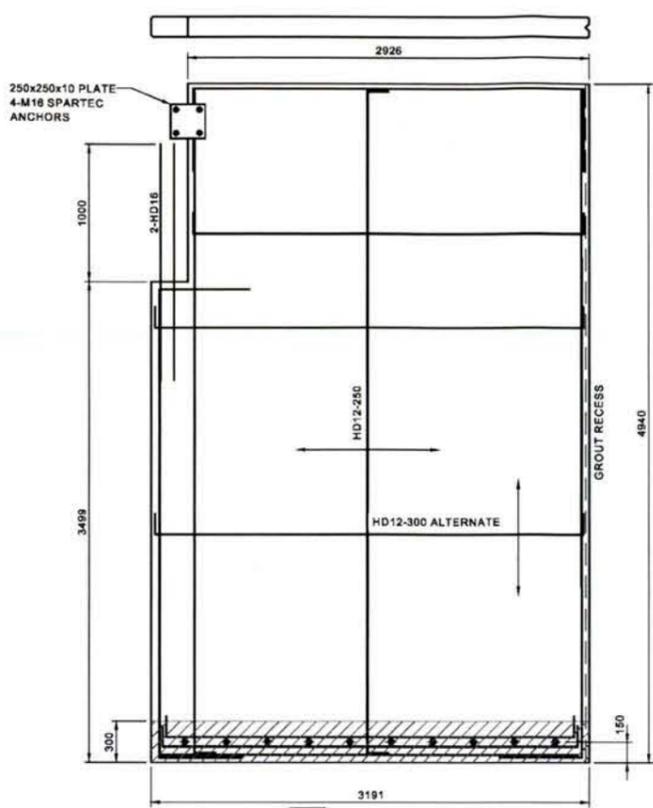

P12 VIEWED FROM INSIDE

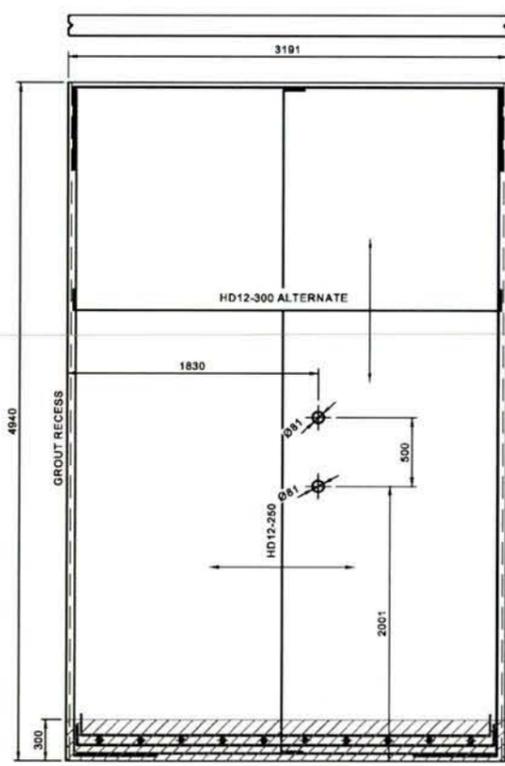


P13 VIEWED FROM INSIDE

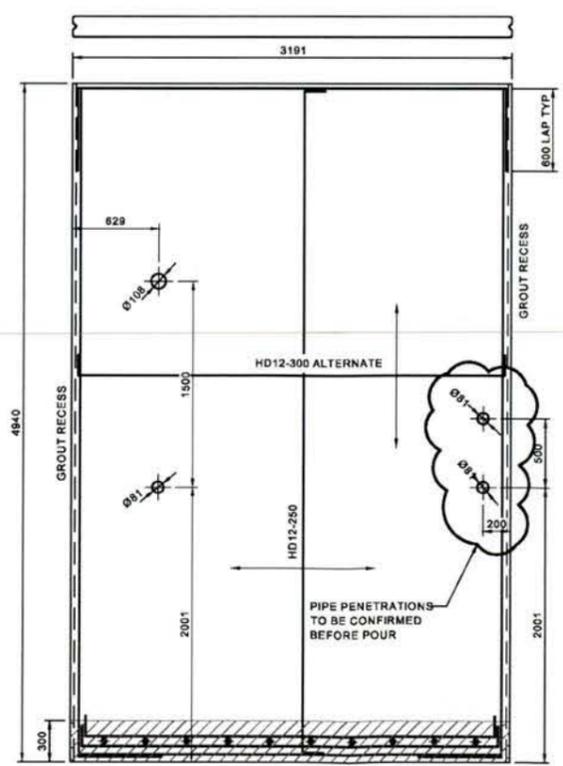

P14 VIEWED FROM INSIDE

**SUPERCEDED**

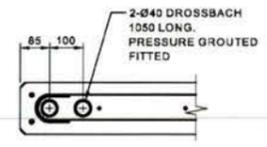

SECTION A-A  
 SCALE 1:10

**SUPERCEDED**

Rev No	ISSUED FOR CONSENT / CONSTRUCTION	ITB	DK	1:12:20
0	ISSUED FOR CONSENT / CONSTRUCTION	ITB	DK	1:12:20
	REVISION DESCRIPTION	DRAWN	APPROVED	DATE

	BY	DATE
DESIGNED	DK	10:20
DESIGN CHECK	DK	11:20
DRAWN	ITB	10:20
APPROVED		

**KENSINGTON CONSULTING**  
 Civil and Structural Engineers  
 03 218 7936 027 403 3773

**GORE WATER TREATMENT PLANT  
 UPGRADE - NEW BUILDING  
 NORTH WALL PRECAST PANELS  
 DETAILS**


STATUS		
CONSENT / CONSTRUCTION		
SCALE AT A1		
PROJECT NUMBER	DRAWING NUMBER	REV
20080	S10	0

20 JAN 2021  
 1:28 PM


**SUPERCEDED**

**SUPERCEDED**


**SUPERCEDED**

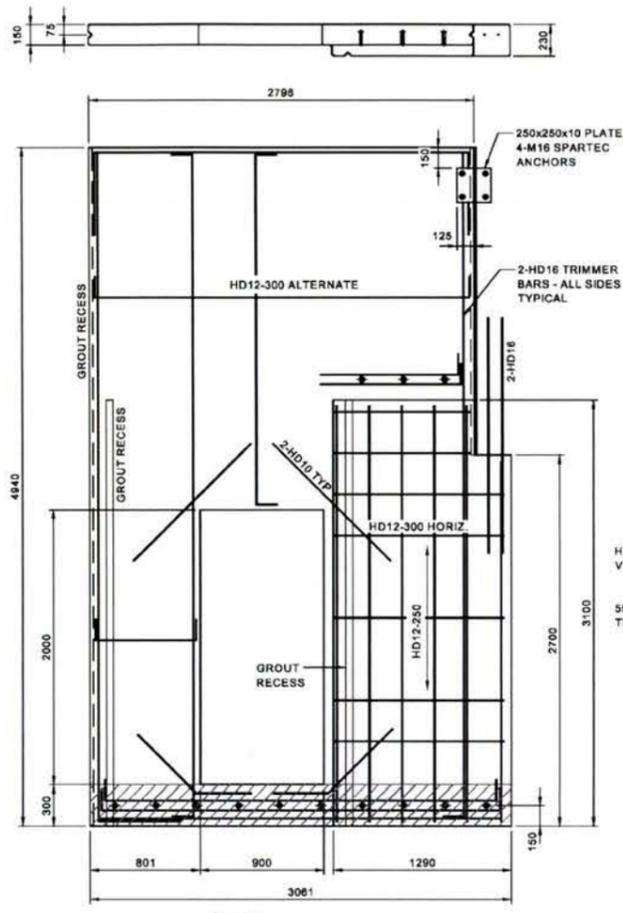


**P15** VIEWED FROM INSIDE

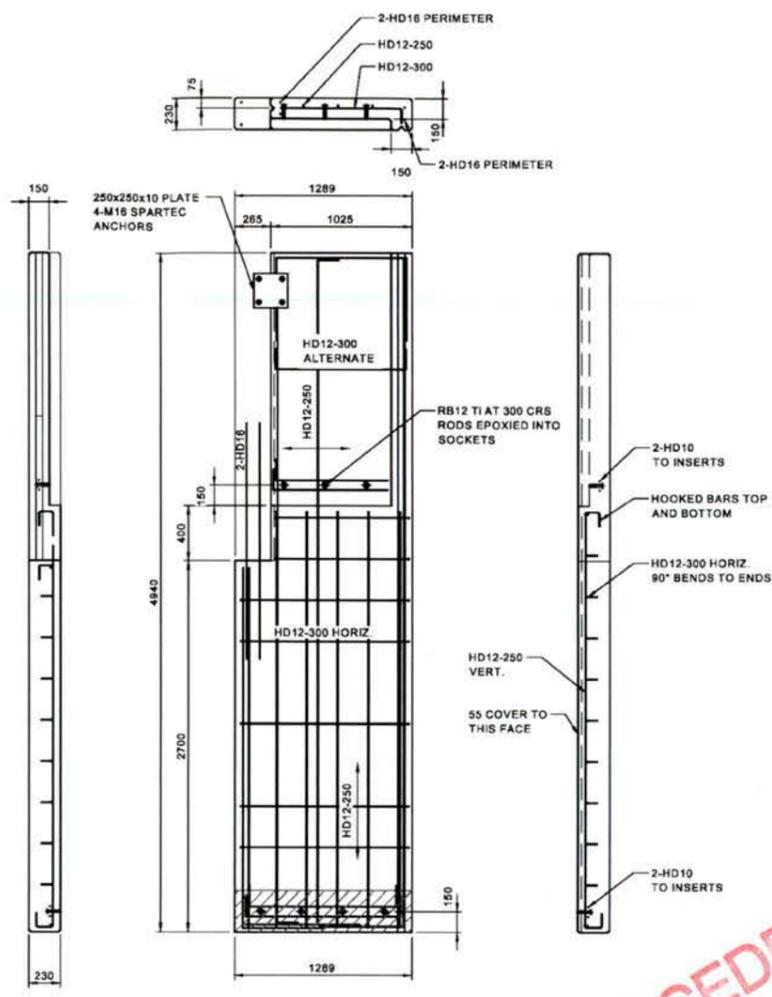

**P17** VIEWED FROM INSIDE

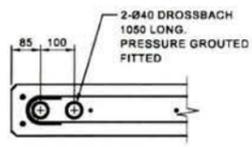

**SECTION A-A**  
 SCALE 1:10

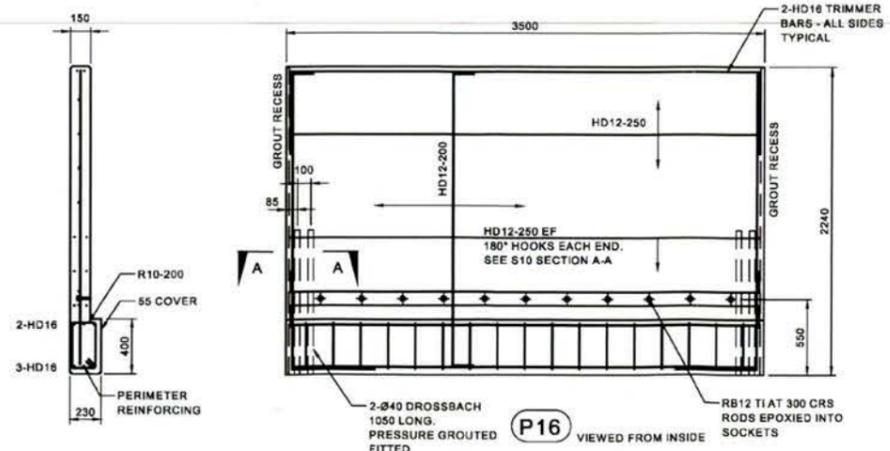

**P16** VIEWED FROM INSIDE

Rev No	ISSUED FOR CONSENT / CONSTRUCTION	ITB	DK	1:12:20
	REVISION DESCRIPTION	DRAWN	APPROVED	DATE
0				

	BY	DATE
DESIGNED	DK	10:20
DESIGN CHECK	DK	11:20
DRAWN	ITB	10:20
APPROVED		

**KENSINGTON CONSULTING**  
 Civil and Structural Engineers  
 03 218 7936 027 403 3773


**GORE WATER TREATMENT PLANT  
 UPGRADE - NEW BUILDING  
 NORTH WALL PRECAST PANELS  
 DETAILS**

STATUS		
CONSENT / CONSTRUCTION		
SCALE AT A1		
PROJECT NUMBER	DRAWING NUMBER	REV.
20080	S11	0


RECEIVED  
 Gore District Council

20 JAN 2021  
 1:28 PM


**SUPERCEDED**

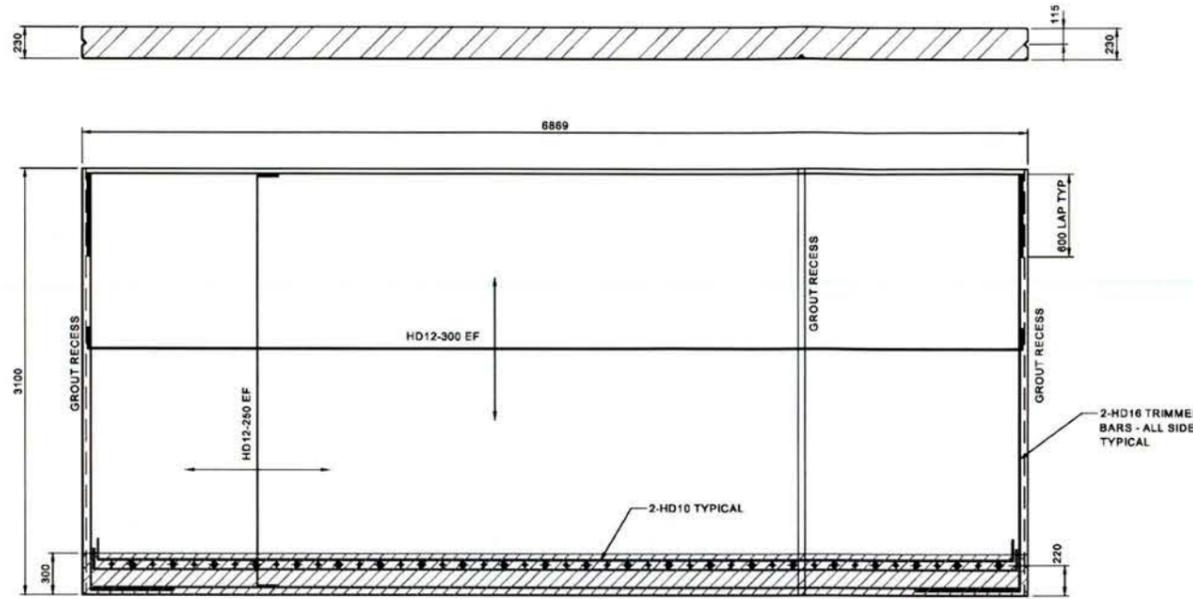

P26

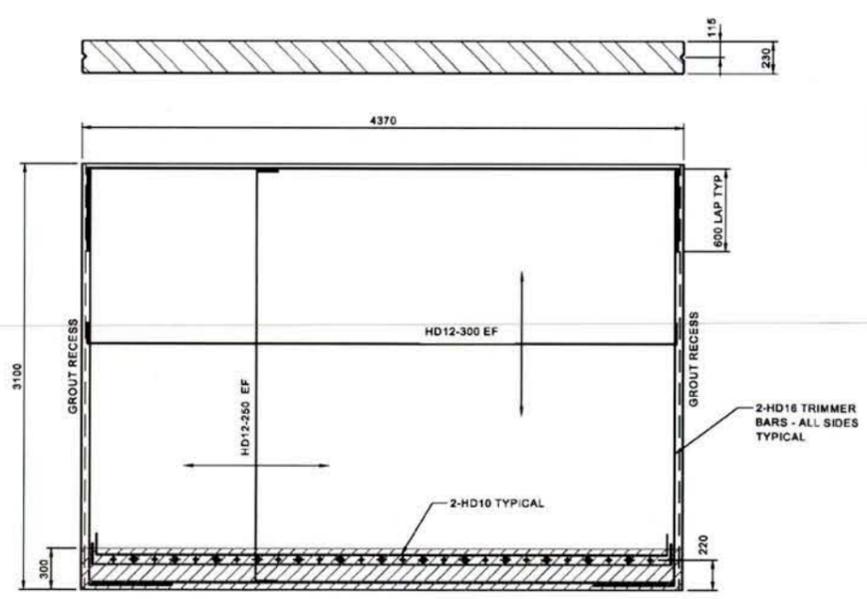

P27 VIEWED FROM INSIDE

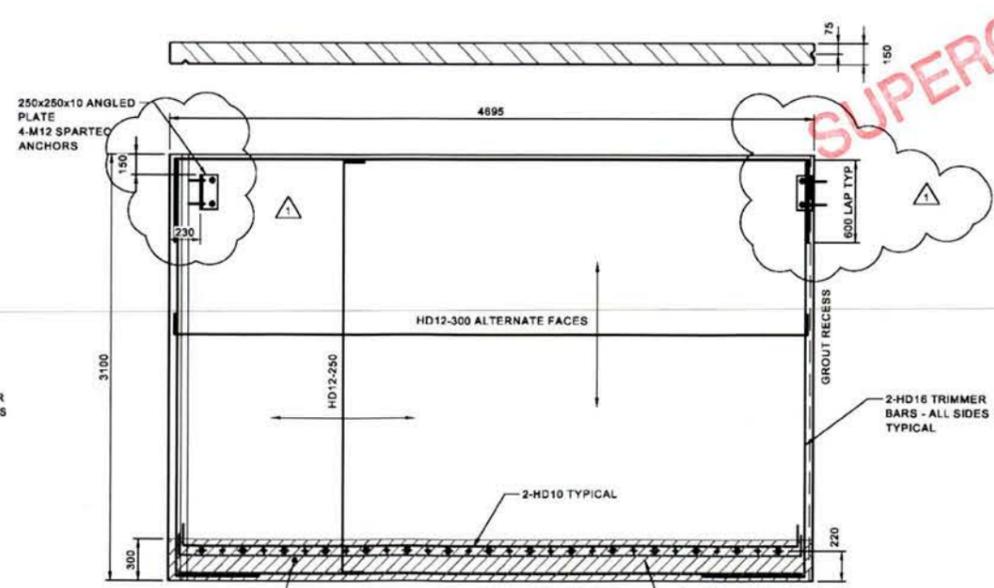

P28 VIEWED FROM INSIDE

**SUPERCEDED**

**SUPERCEDED**

Rev No	REVISION DESCRIPTION	DRAWN	APPROVED	DATE
1	PLATES ADDED TO PANEL P28	ITB	DK	4.12.20
0	ISSUED FOR CONSENT / CONSTRUCTION	ITB	DK	1.12.20

	BY	DATE
DESIGNED	DK	10.20
DESIGN CHECK	DK	11.20
DRAWN	ITB	10.20
APPROVED		


**KENSINGTON CONSULTING**  
 Civil and Structural Engineers  
 03 218 7936 027 403 3773

**GORE WATER TREATMENT PLANT  
 UPGRADE - NEW BUILDING  
 INTERNAL PRECAST PANELS  
 DETAILS**


STATUS		
CONSENT / CONSTRUCTION		
SCALE AT A1		
PROJECT NUMBER	DRAWING NUMBER	REV.
20080	S12	1

Gore District Council  
 20 JAN 2021  
 1:28 PM

ORIGINAL SIZE (A1) DO NOT SCALE PLOT DATE 3-Dec-20  
 ORIGINAL SIZE (A1) DO NOT SCALE

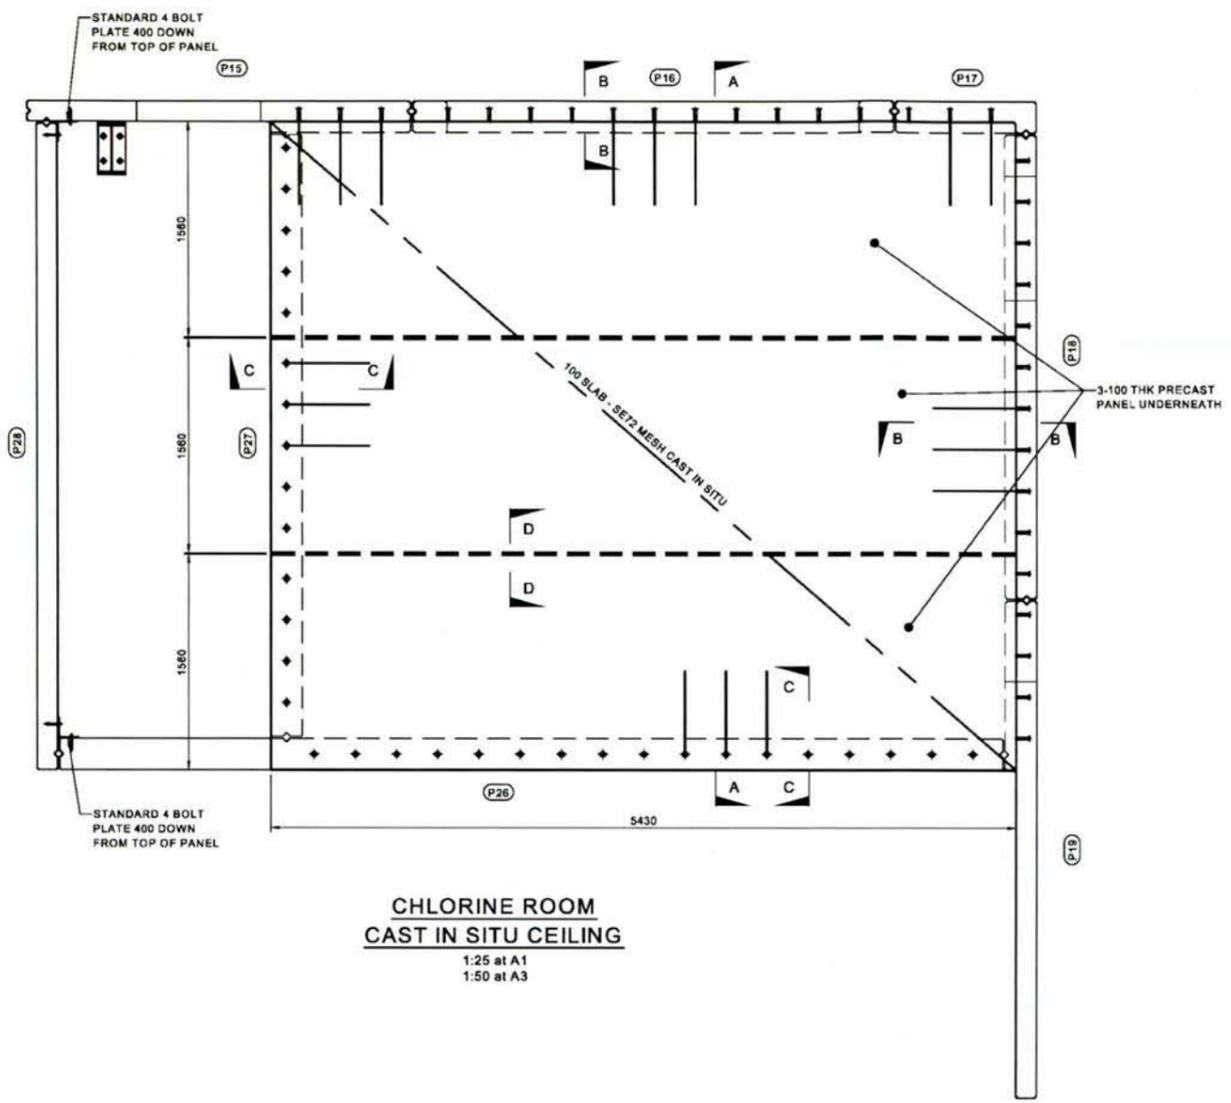

**CHLORINE ROOM  
 CAST IN SITU CEILING**  
 1:25 at A1  
 1:50 at A3

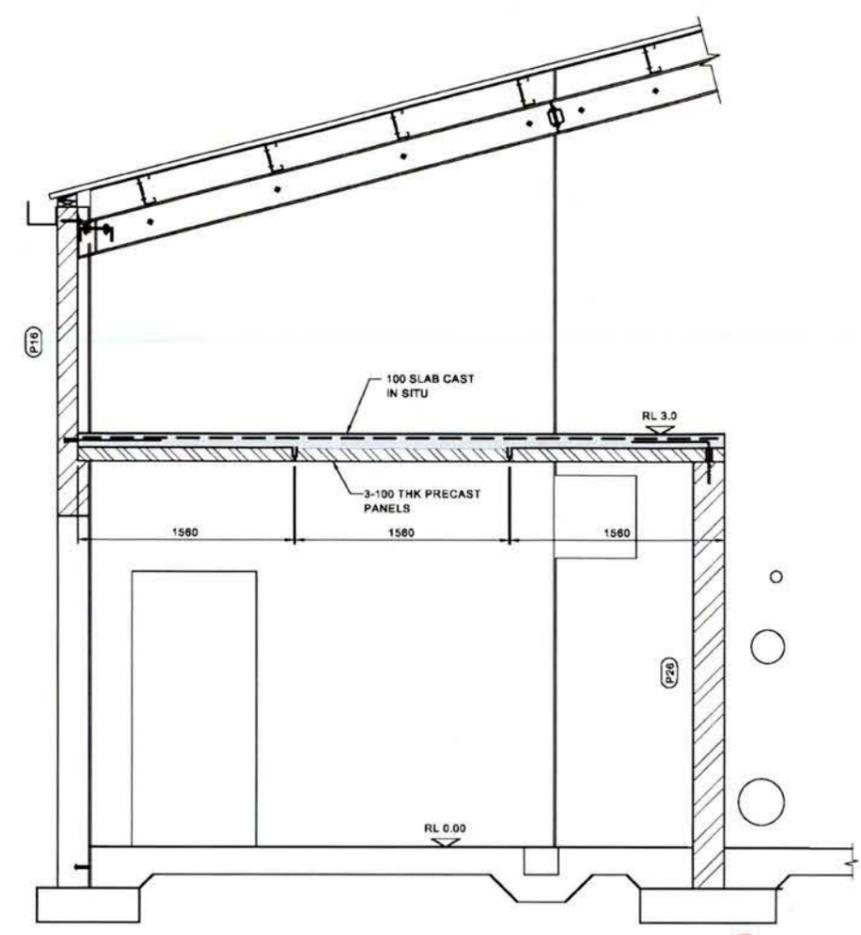


**SECTION A-A**  
 SCALE 1:10


**SUPERCEDED**

**SUPERCEDED**


**SUPERCEDED**

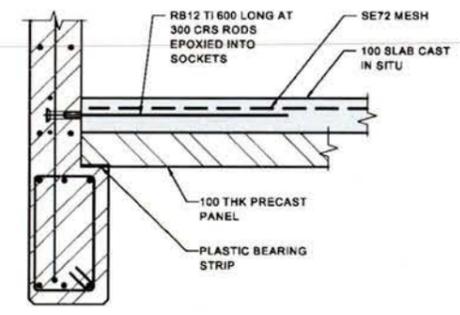

**SECTION B-B**  
 SCALE 1:10

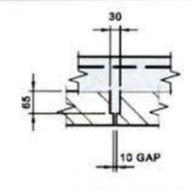

**SECTION C-C**  
 SCALE 1:10

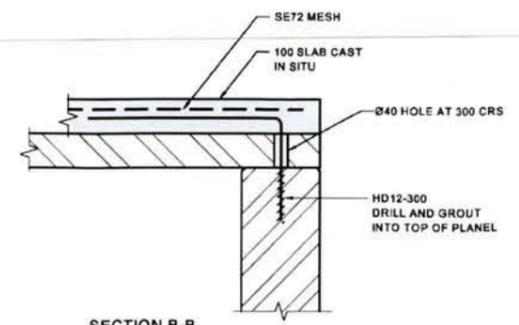

**SECTION B-B**  
 SCALE 1:10

Rev No	REVISION DESCRIPTION	ITB	DK	DATE
0	ISSUED FOR CONSENT / CONSTRUCTION	ITB	DK	2:12:20

	BY	DATE
DESIGNED	DK	10:20
DESIGN CHECK	DK	11:20
DRAWN	ITB	10:20
APPROVED		

**KENSINGTON CONSULTING**  
 Civil and Structural Engineers  
 03 218 7936 027 403 3773

**GORE WATER TREATMENT PLANT  
 UPGRADE - NEW BUILDING  
 CHLORINE ROOM CEILING  
 PLAN AND SECTIONS**

STATUS		
CONSENT / CONSTRUCTION		
SCALE AT A1		
PROJECT NUMBER	DRAWING NUMBER	REV.
20080	S13	0

